IREDELL COUNTY HEALTH DEPARTMENT

STATESVILLE 704-878-5305 MOORESVILLE 704-664-5281

IMPROVEMENT PERMIT / AUTHORIZATION TO CONSTRUCT / OPERATION PERMIT / EXISTING SYSTEM INSPECTION

PERMIT# 14054 PIN# 4728239683 Warren Hager DATE 3-9-07

OWNER OR APPLICANT (Clayton Homes - Statesville) James Elmore / PHONE: Business _____ Home 704 875 6143

ADDRESS 3340 Wilkesboro Hwy

LOCATION Hwy 115 N - From I-40 go 6 miles on the left

SUBDIVISION 0 n/a BLOCK / SECTION _____ LOT 74 LOT AREA .74 SITE CLASS. Ex DESIGN FLOW Ex L.T.A.R. Ex

Septic Tank: Ex Gallons: STB Ex Date Ex

Pump Tank: _____ Gallons: PT _____ Date _____

Pump Make: _____ Model _____ Serial No. _____

Nitrification Field: No Fields Ex Square Feet Ex Linear Feet Ex

No Lines Ex Trench Width Ex Max Trench Bottom Depth Ex Gravel Depth _____

☐ New System ☐ Repair ☐ Expansion System Type: I II III IV V VI

System Description: Ex

Repair System Description: _____

Maintenance Agreement Required: ☐ Yes ☒ No

☐ Gravity ☐ Pressure

☐ House/Mod. Home ☒ Mobile Home ☐ Business ☐ Other _____

No. Bedrooms 3 No. Persons _____ No. Employees _____

Water Supply: ☐ Individual ☐ Public ☐ Community

☐ Slab ☒ Crawl Space ☐ Basement w/plumbing ☐ Basement wo/plumbing


Comments:/Conditions:

Comments:/Conditions:

All Zoning regulations apply

INITIAL SITE SKETCH

AS BUILT SKETCH

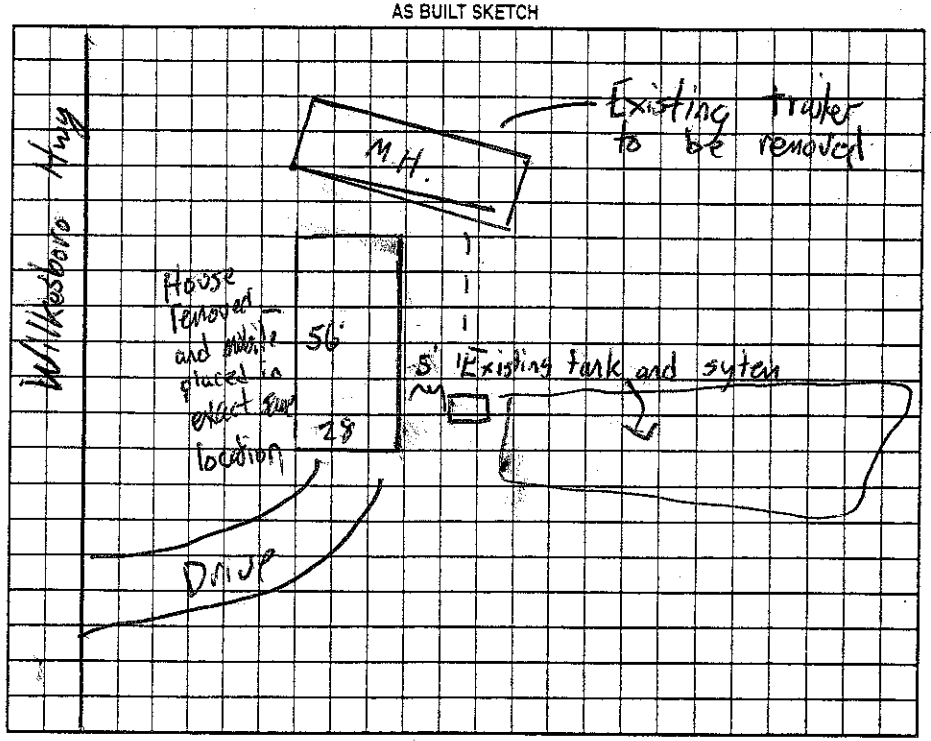

Permit can be suspended or revoked if any false information is supplied toward securing the permit/any unauthorized changes are made to the site/any unauthorized changes are made in the installation of the system. Improvement Permit with plat valid without expiration ☐ Improvement Permit with site plan valid for sixty months ☐ Authorization to Construct is valid for a period equal to that of Improvement Permit – not to exceed sixty months.

Signed: _____ date 3-12-07 Installed by: _____

Improvement Permit by: _____ date _____ Operation Permit by: _____ date _____

Authorization to Construct by: _____ date _____ Existing System Inspection by: _____ date 3-09-07

HEALTH DEPT. COPY: WHITE OWNER COPY (FINAL): YELLOW OWNER COPY (INITIAL): PINK