IREDELL COUNTY HEALTH DEPARTMENT

STATESVILLE 704-878-5305 MOORESVILLE 704-664-5281

IMPROVEMENT PERMIT / AUTHORIZATION TO CONSTRUCT / OPERATION PERMIT / EXISTING SYSTEM INSPECTION

PERMIT# REPAIR PIN# 4728-24-3651 DATE 3-26-02

OWNER OR CONTRACTOR ALLEN MULLINS PHONE: Business 704-880-1623 Home 704-876-0747

ADDRESS 3395 WILKESBORO HWY, STATESVILLE, NC 28625

LOCATION NC 115 NORTH, HOUSE ON LEFT BEFORE ASCOTT ROAD AT BOX # 3395 (BEHIND OLD "BUNTON" STORE)

SUBDIVISION ____ BLOCK / SECTION ____ LOT ____ LOT AREA LIMITED 2.2 acres SITE CLASS PS DESIGN FLOW 240 L.T.A.R. EXISTING

Septic Tank: EXISTING Gallons: STB ____ Date ____

Pump Tank: ____ Gallons: PT ____ Date ____

Pump Make: ____ Model ____ Serial No. ____

Nitrification Field: No Fields 1 Square Feet 450 Linear Feet 150

No Lines THREE Trench Width 36" Max Trench Bottom Depth 36" Gravel Depth 12"

☐ New System ☑ Repair System Type: I. II. III. IV. V. VI

System Description: ____

Repair System Description: CONVENTIONAL GRAVITY

Maintenance Agreement Required: ☐ Yes ☑ No

☑ House/Mod. Home No. Bedrooms 2

☐ Mobile Home No. Bathrooms 1

☐ Business No. Employees ____

☐ Other ____

☐ Slab ☐ Crawl Space ☑ Basement w/plumbing ☐ Basement wo/plumbing


Water Supply: ☑ Individual ☐ Public ☐ Community

WELL

Comments/Condition: ① REPLACE SANITARY TEE IN SEPTIC TANK ② REPLACE 3" x 40' SCH 80 SUPPLY LINE BENEATH DRIVEWAY ③ INSTALL 4 NEW DROP BOXES AT LOCATIONS SHOWN FEEDING BOTH OLD & NEW LINES

Comments/Conditions:

INITIAL SITE SKETCH

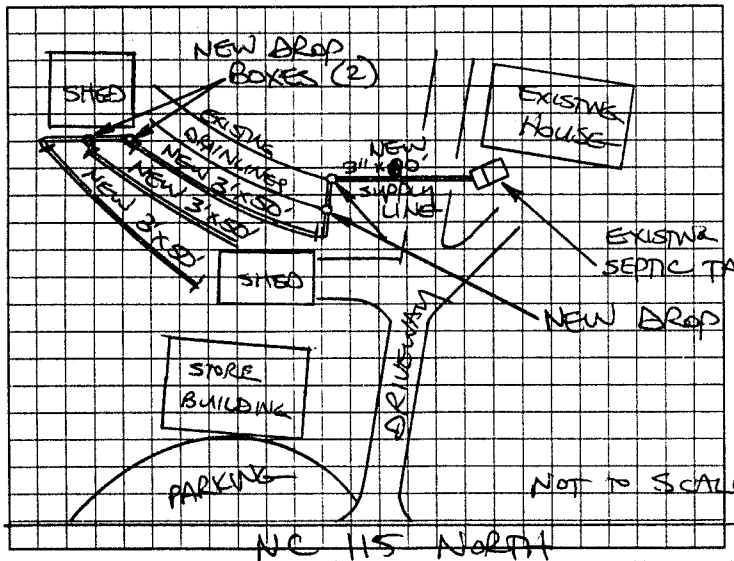

AS BUILT SKETCH

SYSTEM REPAIRED ACCORDING TO INITIAL SITE SKETCH

Permit can be suspended or revoked if any false information is supplied toward securing the permit/any unauthorized changes are made to the site/any unauthorized changes are made in the installation of the system. Improvement Permit with plat valid without expiration. Improvement Permit with site plan valid for sixty months. Authorization to Construct is valid for a period equal to that of Improvement Permit – not to exceed sixty months.

Signed: Allen Mullins date 3/26/02 Installed by: STATESVILLE BACKHOE

Improvement Permit by: STEVE HENDRICK date 3-26-02 Operation Permit by: STEVE HENDRICK date 4-1-02

Authorization to Construct by: STEVE HENDRICK date 3-26-02 Existing System Inspection by: ____ date ____

HEALTH DEPT COPY WHITE OWNER COPY (FINAL) YELLOW OWNER COPY (INITIAL) PINK