e. 1337 TONY WEIBER

IREDELL COUNTY HEALTH DEPARTMENT

STATESVILLE 704-878-5305 MOORESVILLE 704-664-5281

IMPROVEMENT PERMIT / CERTIFICATE OF COMPLETION / OPERATION PERMIT / EXISTING SYSTEM INSPECTION

PROPERTY DESCRIPTION NO. REPAIR DATE 6/30/93 TAX MAP NO. REPAIR

OWNER OR CONTRACTOR RICKY JOHNSON PHONE: Business 876-3906 Home 876-3348

ADDRESS RT 2 BOX 341 STVL NC

LOCATION NC 115 N, ON (L) 2' HOUSES BEFORE OLD PINE RIDGE SERVICE STA, BEFORE ASGAH RD.

SUBDIVISION _____ BLOCK / SECTION _____ LOT _____ LOT AREA _____ SITE CLASS. PS L.T.A.R. 0.4 GPA/A2

Water Supply: ☑ Individual ☐ Community ☐ Public WELL

Septic Tank: 1000 Gallons; STB 358 Date 4/22/93

Pump Tank: _____ Gallons; PT _____ Date _____

Nitrification Field: No Fields 1 Square Feet 600 Linear Feet 200

No Lines 2 Trench Width 36" Trench Depth ≤ 36" Gravel Depth 12"

☐ New System ☑ Repair System Type: I. II (III) IV. V. VI

System Description: _____

Repair System Description: CONV. GRAVITY

Maintenance Agreement Required: ☐ Yes ☑ No

☑ House/Mod. Home No. Bedrooms 2

☐ Mobile Home No. Bathrooms 1

☐ Business No. Employees _____

☐ Other _____

☐ Slab ☑ Crawl Space ☐ Basement w/plumbing ☑ Basement wo/plumbing

Garbage Disposal: ☐ Yes ☑ No


Auto. Dishwasher: ☐ Yes ☐ No

Auto. Washing Machine: ☑ Yes ☐ No

Other ✓

Comments (1) ABANDON EXISTING SYSTEM (2) RECOMMEND REMOVING MAPLE TREE

INITIAL SITE SKETCH

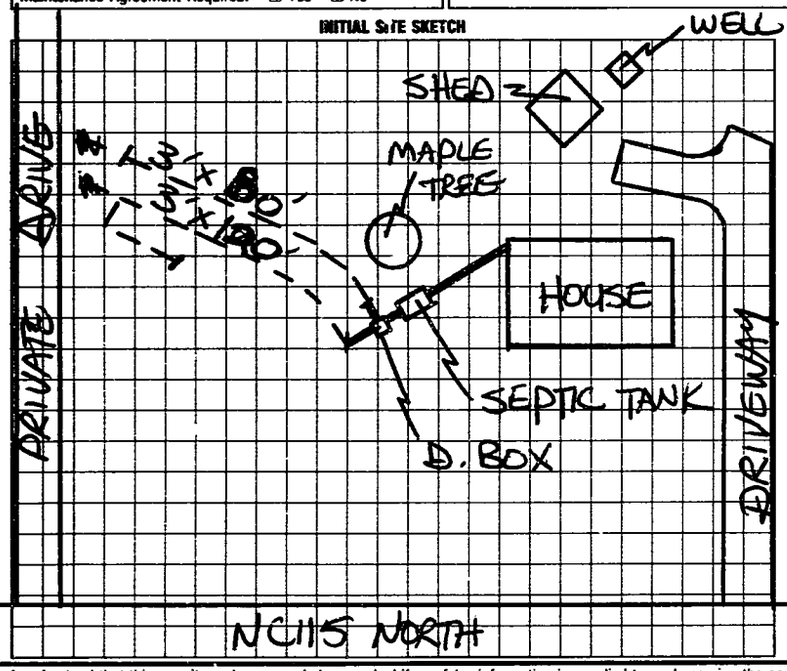

AS BUILT SKETCH

SYSTEM INSTALLED ACCORDING TO INITIAL SITE SKETCH

I understand that this permit can be suspended or revoked if any false information is supplied toward securing the permit/any unauthorized changes are made to the site/any unauthorized changes are made in the installation of the system. Improvement Permit is valid for 60 months from date of issuance.

Signed: Ricky Johnson

Improvement Permit by: STEVE HEDRICK date 6/30/93

Existing System Inspection by: _____ date _____

Installed by: A-1 BACKHOE

Certificate of Completion by: STEVE HEDRICK date 7/6/93

Operation Permit by: _____ date _____

HEALTH DEPT. COPY: WHITE INSPECTION COPY (FINAL): GREEN OWNER COPY (FINAL): YELLOW INSPECTION COPY (INITIAL): PINK OWNER COPY (INITIAL): GOLD

J