ICHD - ENVIRONMENTAL HEALTH DIVISION

Statesville Office (704) 878-5305 Mooresville Office (704) 660-3625

PERMIT # 2023-42490

SEPTIC: IMPROVEMENT PERMIT / AUTHORIZATION TO CONSTRUCT / OPERATION PERMIT / EXISTING SYSTEM

PIN # 4728 -- 24 -- 6856

APPLICANT/OWNER: Mary Petty APPLICANT ADDRESS: 126 Odom Ln, Statesville

SITE ADDRESS: 126 Odom Ln, Statesville 28625 PHONE: 850-353-1040 ALT. PHONE -

SITE DIRECTIONS: 115 N - Odom SAP CONTROLLED: ☐ YES ☐ NO

SUBDIVISION: - SECTION: - LOT # - LOT AREA: 4.81 acres DESIGN FLOW: 240 gpd L.T.A.R.: EX

Septic Tank	EX	(gal)	STB		Date						
Pump Tank		(gal)	PT		Date						
Pump Make		Model			Serial #						
# Nitrification Fields	EX	# Lines	EX		Linear Ft	EX					
Trench Width	EX	Trench Bottom Depth(Low side)	EX		Gravel Depth	EX					

☐ New System ☐ Repair ☐ Expansion System Type: I II (III) IV V VI

System Description: EXISTING

Repair System Description:

Maintenance Agreement Required: ☐ YES ☒ NO

☒ GRAVITY ☐ PRESSURE

☒ Residence No. Bedrooms 2

☐ Business No. Persons 4

☐ Other No. Employees

☐ Slab ☒ Crawl Space

☐ Basement w/plumbing ☐ Basement w/o plumbing

Water Supply


☒ Private

☐ Public

☐ Community


Comments / Conditions: System appeared to be working at time of inspection.

INITIAL SITE SKETCH

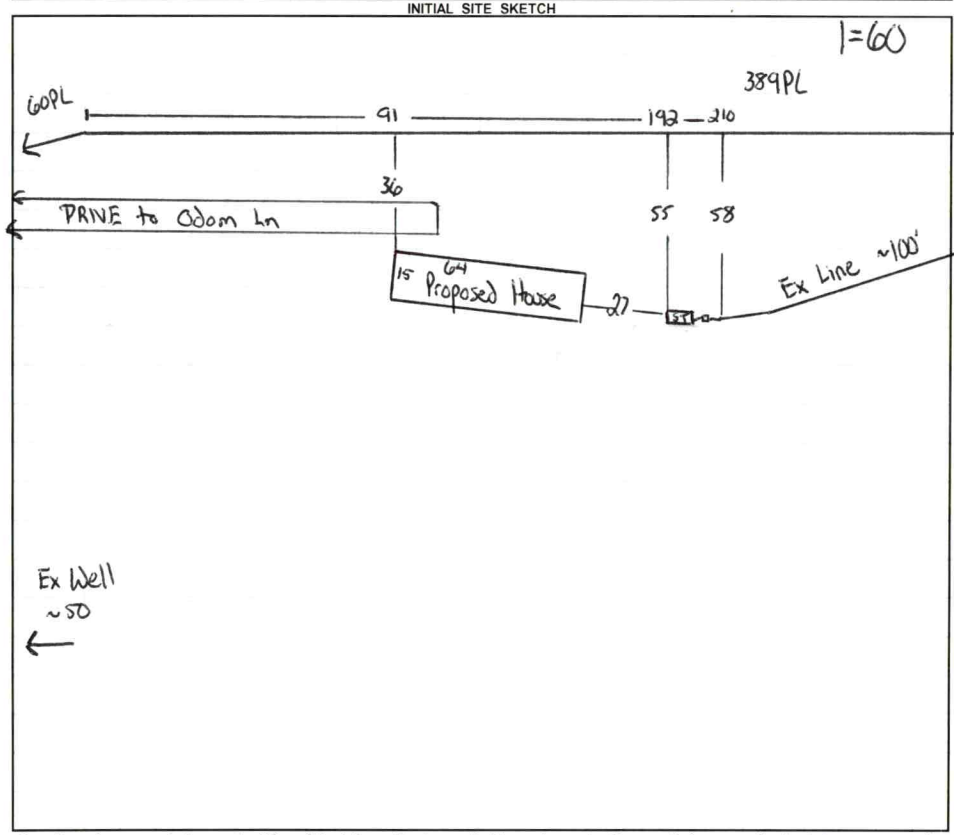

AS BUILT SKETCH

FOR SEPTIC FINAL INSPECTION CALL: 704-664-3703 between 8am-9am the day the inspection is needed. Be sure to speak with an inspector to confirm your time.

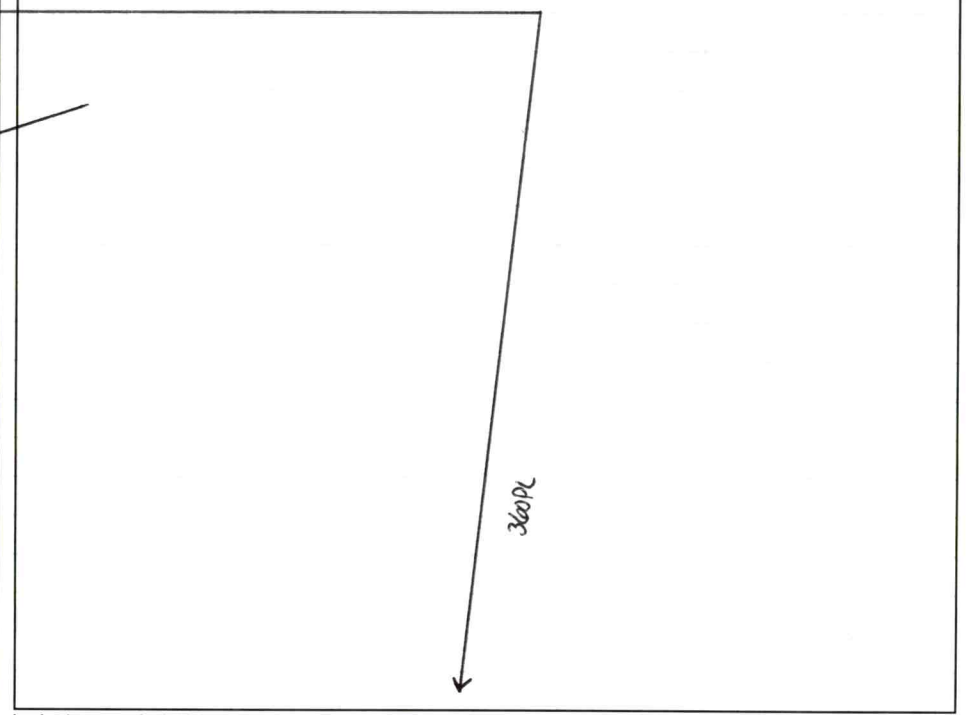

Permit can be suspended or revoked if any false information is supplied toward securing the permit / any unauthorized changes are made to the site / any unauthorized changes are made in the installation of the system. **CONTACT A LOCATOR SERVICE PRIOR TO ANY EXCAVATION**

☐ **IMPROVEMENT PERMIT** ***with plat*** *valid without expiration.* ☐ **IMPROVEMENT PERMIT** ***with site plan*** *valid for 60 mos.* ☐ **AUTHORIZATION TO CONSTRUCT** *valid for period equal to IMPROVEMENT PERMIT--not to exceed 60 mo.*

Owner / Applicant Signature: Online Signature Date: Installed by:


IMPROVEMENT PERMIT by: Date: OPERATION PERMIT by: Date:

AUTHORIZATION TO CONSTRUCT by: Date: Existing System Inspected by: Date: 1/16/24

FOR SEPTIC FINAL INSPECTION: CALL 704-664-3703 between 8am-9am the day the inspection is needed.

Item	Date	Initials
Drain Lines Checked		
Tanks Checked		
Pressure Manifold or Valve Box Checked		
Pressure Head Set		
Electrical Checked		
Floats Set		
Alarm Checked		
Maintenance Contract Needed? Y / N		
Comments:		

Repairs Only	
	State Code
Failing System Code	
Type of Distribution	G or P
Type of Failure/Malfunction	
Primary Cause of Failure/Malfunction	
Age of System? _____	
Initial or Repair? _____	

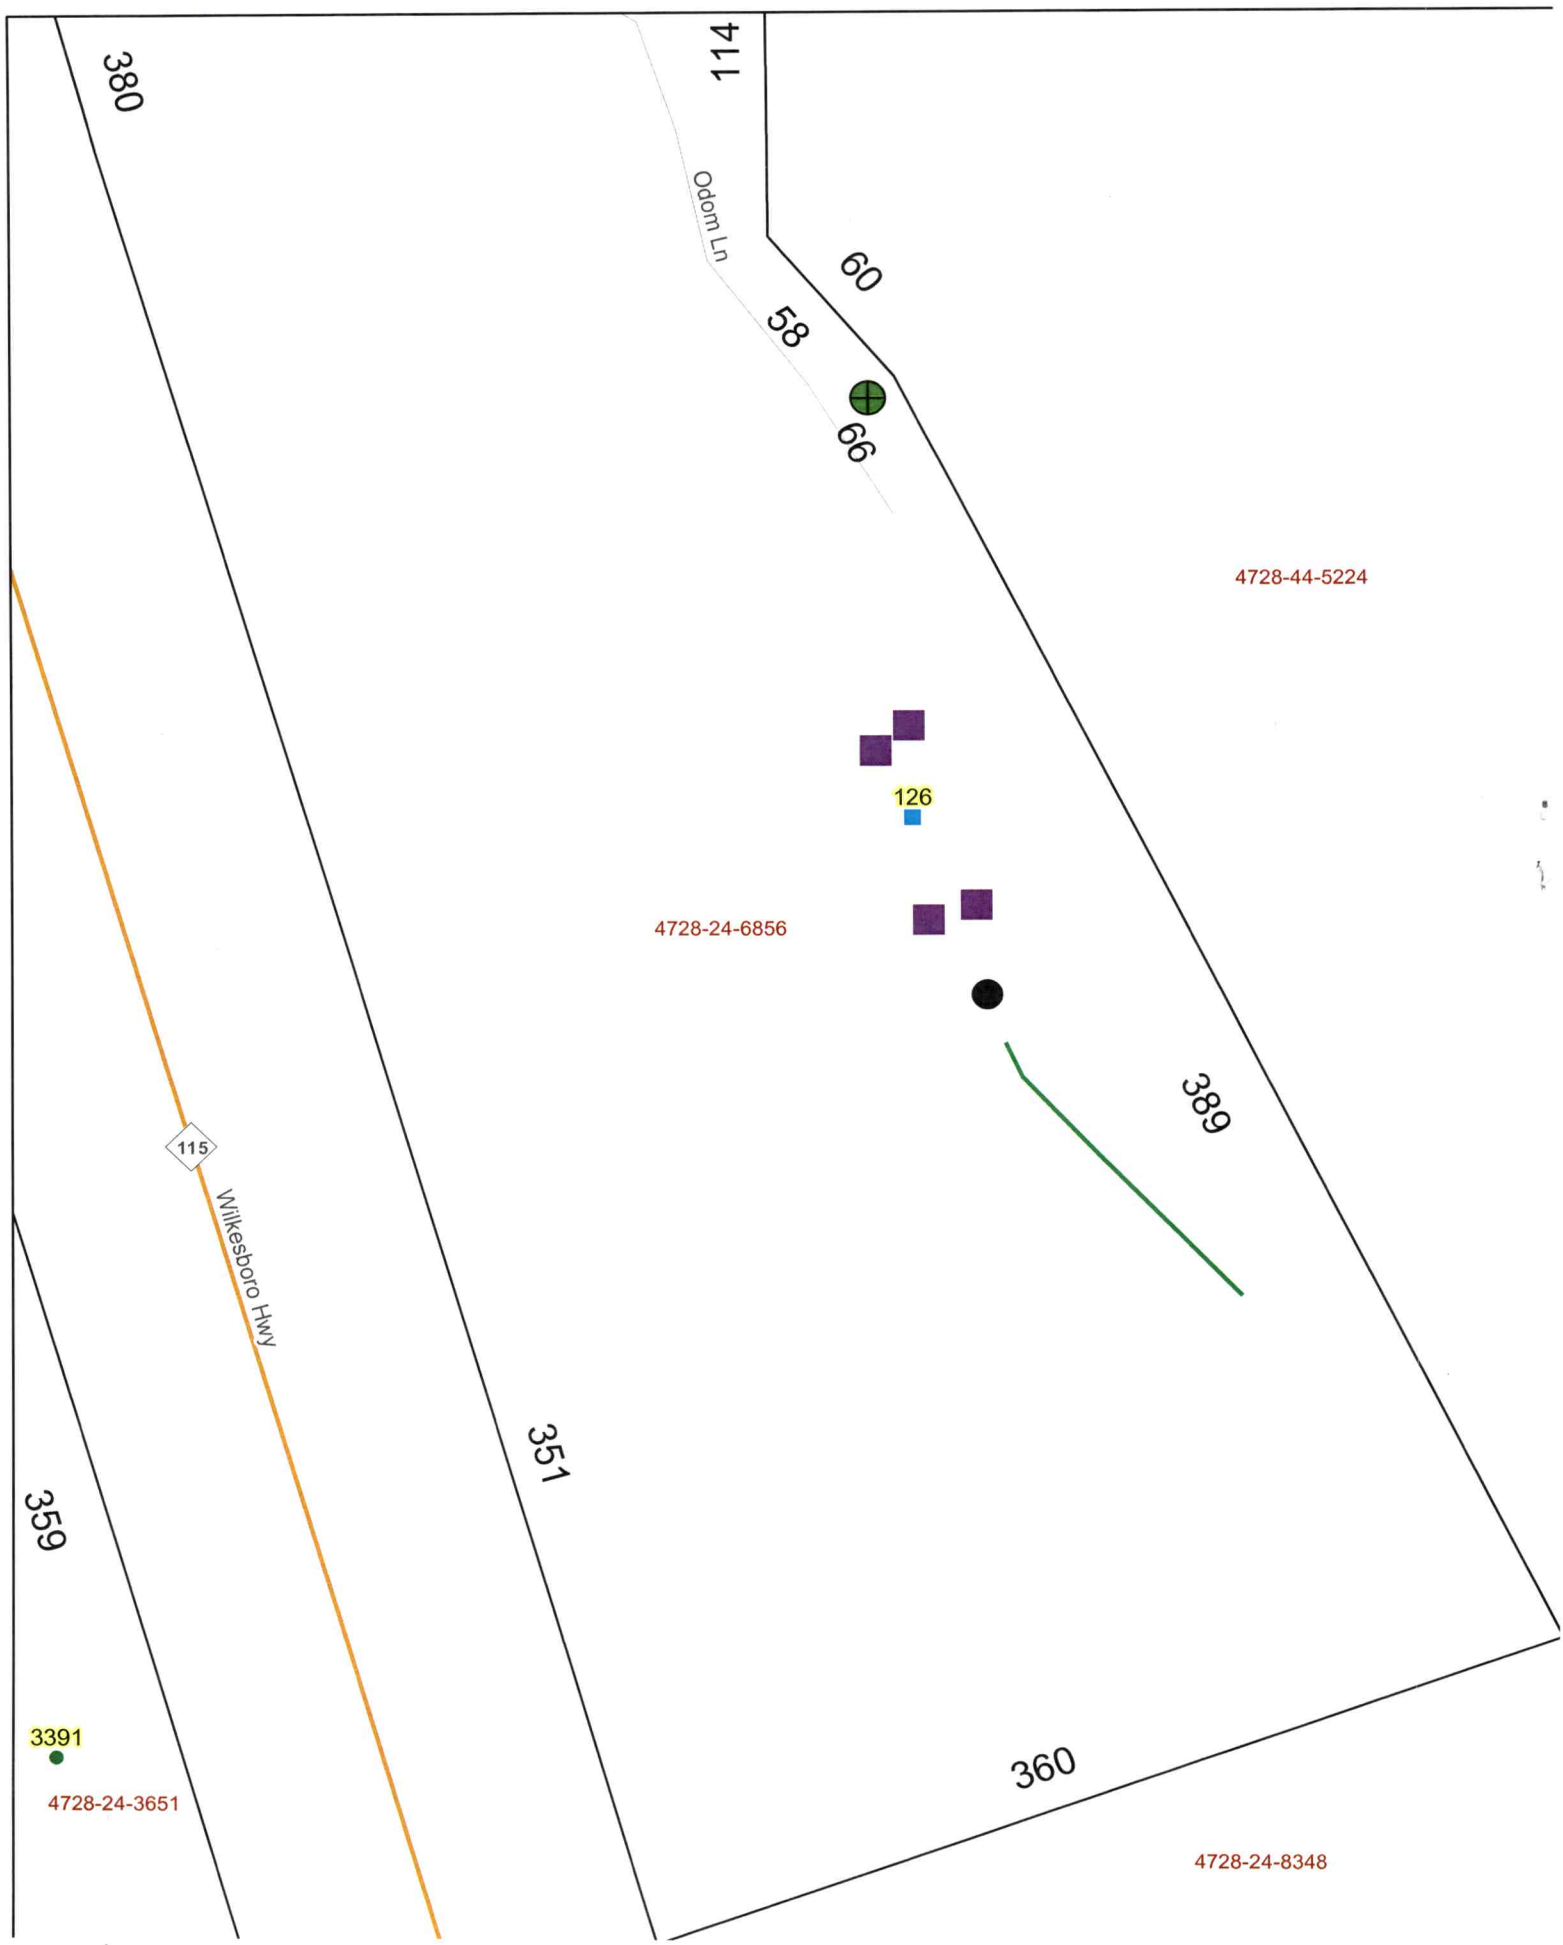
380
114
Odom Ln
60
58
66
4728-44-5224
126
4728-24-6856
389
115
Wilkesboro Hwy
351
359
3391
4728-24-3651
360
4728-24-8348