12:00 58324

IREDELL COUNTY HEALTH DEPARTMENT

STATESVILLE 704-878-5305 MOORESVILLE 704-664-5281

IMPROVEMENT PERMIT / CERTIFICATE OF COMPLETION / OPERATION PERMIT / EXISTING SYSTEM INSPECTION

PROPERTY DESCRIPTION NO. 21225 DATE 8-7-95 TAX MAP NO. 14B-A-63 Watershed: ☐ Yes ☑ No

OWNER OR CONTRACTOR JAMES S. ELMORE PHONE: Business 878-0702 Home 873-9830

ADDRESS 761 N. MULBERRY ST. STATESVILLE, NC 28677

LOCATION NC 115 N, CROSS S. YADKIN RIVER ~ 0.25 MILE ON RIGHT

SUBDIVISION _____ BLOCK / SECTION _____ LOT _____ LOT AREA 1.92 AC. SITE CLASS. P3 DESIGN FLOW 240 L.T.A.R. 0.3 GPD/FT2

Septic Tank: 1000 Gallons; STB 794 Date 5-30-95

Pump Tank: 1000 Gallons; PT 27 Date 7-10-95

Pump Make: _____ Model EQUIVALENT Serial No. _____

Nitrification Field: No Fields 1 Square Feet 300 Linear Feet 210

No Lines 3 Trench Width 36" Max Trench Bottom Depth 36" Gravel Depth N/A

☑ New System ☐ Repair System Type: I II III IV V VI

System Description: PUMP FED CHAMBERS

Repair System Description: PUMP FED CHAMBERS

Maintenance Agreement Required: ☐ Yes ☑ No

☐ House/Mod. Home ☑ Mobile Home ☐ Business ☐ Other

No. Bedrooms 3 No. Bathrooms 2 No. Employees ____


☐ Slab ☐ Crawl Space ☐ Basement w/plumbing ☐ Basement wo/plumbing

Water Supply: ☐ Individual ☐ Community ☐ Public WELL

Comments: ① KEEP SYSTEM MINIMUM 65' FROM WELL (MAX FEASIBLE DISTANCE) ② SEE ATTACHED SHEETS FOR PUMP AND PRESSURE MANIFOLD REQUIREMENTS.

Comments: Checked Septic Tank and pump tank on 8-14-95. MPD. Check drainfield, pressure manifold, pump, and floats on 8-15-95. Inspected NEMA 4X Box, and alarm on 11-9-95 MPD.

INITIAL SITE SKETCH

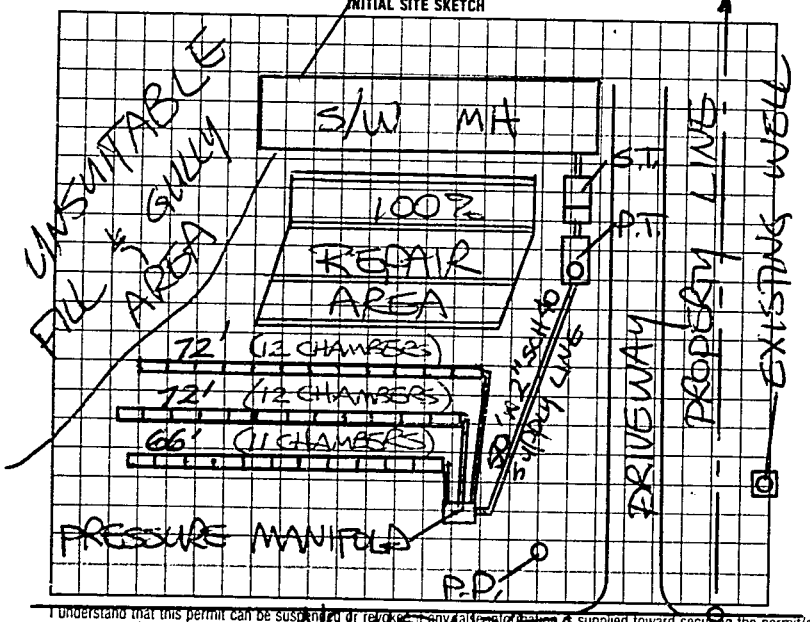

AS BUILT SKETCH

SAME AS INITIAL SKETCH

I understand that this permit can be suspended or revoked if any false information is supplied toward securing the permit/any unauthorized changes are made to the site/any unauthorized changes are made in the installation of the system.

Signed: Sanford Elmore

Improvement Permit by: STEVE HEDRICK date 8-7-95

Existing System Inspection by: _____ date _____

Installed by: JAMES HUDLER

Certificate of Completion by: ~~STEVE HEDRICK~~ date ~~11-9-95~~

Operation Permit by STEVE HEDRICK date 11-9-95

HEALTH DEPT. COPY: WHITE INSPECTION COPY (FINAL): GREEN OWNER COPY (FINAL): YELLOW INSPECTION COPY (INITIAL): PINK OWNER COPY (INITIAL): GOLD

702000