IREDELL COUNTY HEALTH DEPARTMENT - *ENVIRONMENTAL HEALTH* ☑ STATESVILLE OFFICE 704-878-5305 ☐ MOORESVILLE OFFICE 704-664-5281

IMPROVEMENT PERMIT / AUTHORIZATION TO CONSTRUCT @ OPERATION PERMIT / EXISTING SYSTEM INSPECTION

PERMIT # 17206 4 PIN # 4728250320 DATE 5-11-12

OWNER Tiffany Jones APPLICANT: Same PHONE: Home/Cell # N/A Business # 704 239-3693

SITE ADDRESS Wilkesboro Hwy Statesville OWNER / APPLICANT ADDRESS 117 Valley Springs Dr. Olin

SITE DIRECTIONS Hwy 115N, Property on Left just before Pisgah Ch. Rd.

SUBDIVISION N/A BLOCK / SECTION N/A LOT # N/A LOT AREA 3.104 acres DESIGN FLOW 360 gpd L.T.A.R. 0.3

Septic Tank 1000 Gallons: STB 760 Date 4-4-12
Pump Tank ____ Gallons: PT ____ Date ____
Pump Make ____ Model ____ Serial # ____
No. Nitrification Fields: 1 No. Lines 4 Linear Feet 400
Trench Width 36" Max. Trench Bottom Depth 36" Gravel Depth 12"


☑ New System ☐ Repair ☐ Expansion System Type I (II) III IV V VI
System Description: Conventional 25% Reduction
Repair System Description: 25% Reduction
Maintenance Agreement Required ☐ YES ☑ NO
☑ GRAVITY ☐ PRESSURE

☑ Residence No. Bedrooms 3
☐ Business No. Persons ____
☐ Other No. Employees ____
☐ Slab ☑ Crawl Space
☐ Basement w/plumbing ☐ Basement w/o plumbing

Water Supply: ☑ Private ☐ Public ☐ Community

Comments / Conditions
Install Conventional system on contour w/ serial distribution
- An accepted system may also be installed
- Red Polylock filter installed

INITIAL SITE SKETCH

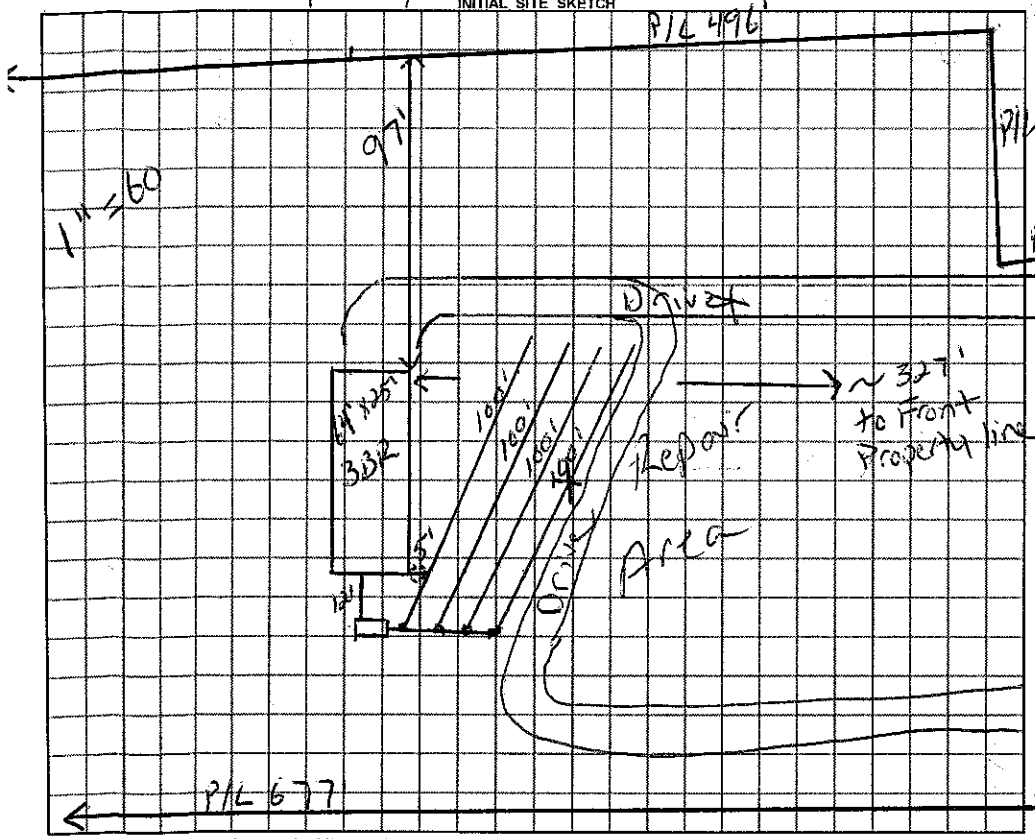

AS BUILT SKETCH

Acc 36 25% Reduction Installed
- Driveway moved to other side of house from original permit
- Parking still on Right side of house.
- Top 3 lines installed as drawn

Permit can be suspended or revoked if any false information is supplied toward securing the permit / any unauthorized changes are made to the site / any unauthorized changes are made in the installation of the system.

☐ *IMPROVEMENT PERMIT with plat valid without expiration* ☑ *IMPROVEMENT PERMIT with plat valid without expiration.* site plan valid 60 mo. ☑ *AUTHORIZATION TO CONSTRUCT* valid for period equal to IMPROVEMENT PERMIT--not to exceed 60 mo.

Owner / Applicant Signature: Derrel Abee Date 5/14/12 Installed by: Tim Abee

IMPROVEMENT PERMIT by: Justin Henderson REHS Date 5-11-12 OPERATION PERMIT by: Justin Henderson REHS Date 8-29-12

AUTHORIZATION TO CONSTRUCT by: Justin Henderson REHS Date 5-11-12 Existing System Inspected by: ____ REHS Date ____

YOU SHOULD CONTACT A LOCATOR SERVICE PRIOR TO ANY EXCAVATION

White Copy – Environmental Health YELLOW COPY (Final) Owner / Applicant PINK COPY (Initial) Owner / Applicant