IREDELL COUNTY HEALTH DEPARTMENT

STATESVILLE 704-878-5305 (C) MOORESVILLE 704-664-5281

IMPROVEMENT PERMIT / AUTHORIZATION TO CONSTRUCT / OPERATION PERMIT / EXISTING SYSTEM INSPECTION

PERMIT# 12738 PIN# 4728-25-6816 DISPOSITIVE HOSSUB DATE 5-2-05

OWNER OR CONTRACTOR WILFORD BAILEY PHONE: Business 704-352-1700 Home 704-450-1541

ADDRESS 872 BAILEY FARM RD STATESVILLE, NC 28625

LOCATION 115 N (E) BAILEY FARM 320 LOT ON LEFT

SUBDIVISION _____ BLOCK / SECTION _____ LOT _____ LOT AREA 1.418AC SITE CLASS PS DESIGN FLOW 360 L.T.A.R. .13

Septic Tank: 1000 Gallons; STB 1012 Date 11-28-04
Pump Tank: _____ Gallons; PT _____ Date _____
Pump Make: _____ Model _____ Serial No. _____
Nitrification Field: No Fields 1 Square Feet EQ=1700' Linear Feet 300'
No Lines 4x75' Trench Width 36" Max Trench Bottom Depth 36" Gravel Depth N/A

[X] New System [ ] Repair System Type: I, II, III, IV, V, VI
System Description: 6BAY DSAPTD
Repair System Description: LP 50% REDUCT
Maintenance Agreement Required: [ ] Yes [X] No


[X] House/Mod. Home No. Bedrooms 3
[ ] Mobile Home No. Bathrooms 3
[ ] Business No. Employees _____
[ ] Other _____
[ ] Slab [X] Crawl Space [ ] Basement w/plumbing [ ] Basement wo/plumbing

Water Supply: [X] Individual [ ] Public [ ] Community WELL

Comments:/Conditions: (1) MARK SIDE P/L & KEEP SYSTEM 10' OFF P/L (2) INSTALL LINES ON CONTOURS + MAINTAIN SETBACKS

Comments:/Conditions: SEPTIC TANK WITH MARKER INSTALLED USING "TUFTITE" FILLER

INITIAL SITE SKETCH

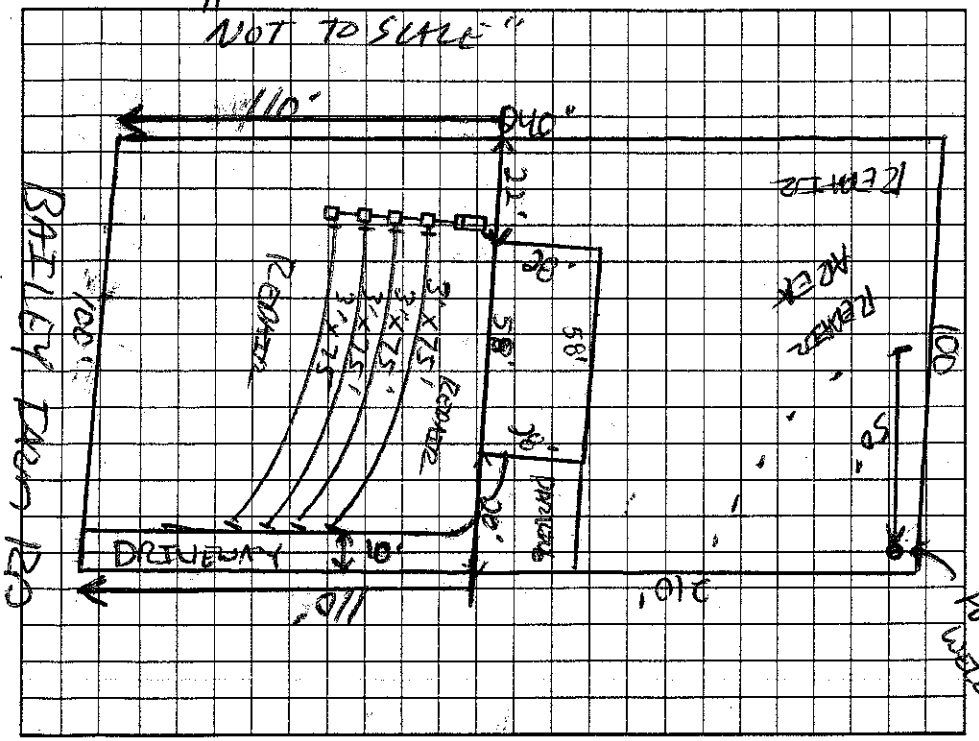

AS BUILT SKETCH

SYSTEM INSTALLED ACCORDING TO INITIAL SITE SKETCH USING 75 "QUICK-4" INFILTRATOR CHAMBERS

Permit can be suspended or revoked if any false information is supplied toward securing the permit/any unauthorized changes are made to the site/any unauthorized changes are made in the installation of the system. Improvement Permit with plat valid without expiration/Improvement Permit with site plan valid for sixty months. Authorization to Construct is valid for a period equal to that of Improvement Permit – not to exceed sixty months.

Signed: _____ date 5-12-05 Installed by: A-1 BACKHOE

Improvement Permit by: _____ date 5-2-05 Operation Permit by: STEVE HEDRICK date 6-29-05

Authorization to Construct by: _____ date 5-2-05 Existing System Inspection by: _____ date _____

HEALTH DEPT. COPY: WHITE OWNER COPY (FINAL): YELLOW OWNER COPY (INITIAL): PINK