IREDELL COUNTY HEALTH DEPARTMENT

STATESVILLE 704-878-5305 MOORESVILLE 704-664-5281

IMPROVEMENT PERMIT / AUTHORIZATION TO CONSTRUCT / OPERATION PERMIT / EXISTING SYSTEM INSPECTION

PERMIT# REPAIR PIN# 4728-26-0239 DATE 1-16-03

OWNER OR CONTRACTOR DOUGLAS E & BETTY PARSONS PHONE: Business Home 704-876-3600

ADDRESS 3473 WILKESBORO HWY, STATESVILLE, NC 28625-1250

LOCATION NC 115 NORTH, 2ND DRIVE ON LEFT, PAST PISGAH CHURCH ROAD.

SUBDIVISION BLOCK / SECTION LOT LOT AREA 1.78 ACRE SITE CLASS PS DESIGN FLOW 360 L.T.A.R. EXISTING

Septic Tank: EXISTING Gallons; STB Date

Pump Tank: Gallons; PT Date

Pump Make: Model Serial No.

Nitrification Field: No Fields 1 Square Feet Linear Feet 180

No Lines THREE Trench Width 36" Max Trench Bottom Depth AS SHALLOW AS POSSIBLE

☐ New System ☑ Repair System Type: I (II) III, IV, V, VI

System Description:

Repair System Description: CONVENTIONAL, GRAVITY

Maintenance ~~Agreement~~ Required: ☐ Yes ☑ No

Gravel Depth 24"

☑ House/Mod. Home No. Bedrooms 3

☐ Mobile Home No. Bathrooms 3

☐ Business No. Employees

☐ Other


☐ Slab ☐ Crawl Space ☑ Basement w/plumbing ☐ Basement wo/plumbing

Water Supply: ☑ Individual ☐ Public ☐ Community WELL

Comments:/Conditions: (1) INSTALL NEW LINES AS FLAGGED USING 24" STONE TIED IN TO BOTH AREAS OF SEWAGE FAILURE (2) THIS PERMIT SERVES AS "NOTICE OF VIOLATION" SYSTEM TO BE REPAIRED BY 2-16-03

Comments:/Conditions: NO VEHICULAR TRAFFIC ALLOWED OVER DRAINFIELD.

INITIAL SITE SKETCH

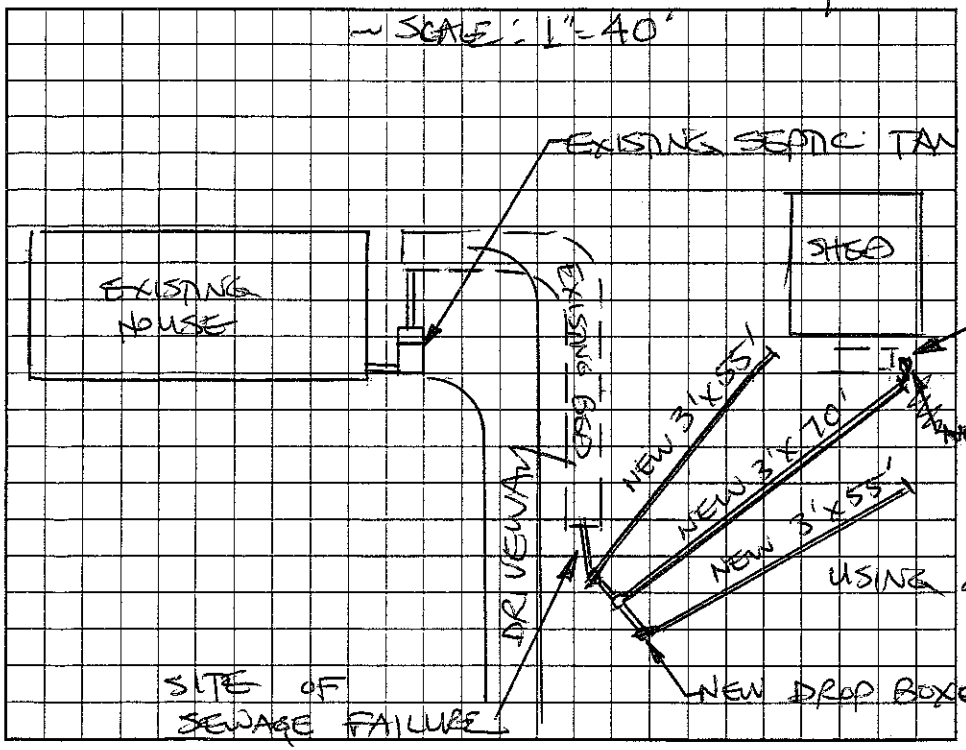

AS BUILT SKETCH

SYSTEM REPAIRED ACCORDING TO INITAL SITE SKETCH

Permit can be suspended or revoked if any false information is supplied toward securing the permit/any unauthorized changes are made to the site/any unauthorized changes are made in the installation of the system. Improvement Permit with plat valid without expiration. Improvement Permit with site plan valid for sixty months. Authorization to Construct is valid for a period equal to that of Improvement Permit – not to exceed sixty months.

Signed: Betty Parsons date 1-16-03 Installed by: JAMES HUDLER

Improvement Permit by: STEVE HENDRICK date 1-16-03 Operation Permit by: STEVE HENDRICK date 2-13-03

Authorization to Construct by: STEVE HENDRICK date 1-16-03 Existing System Inspection by: date

HEALTH DEPT. COPY: WHITE OWNER COPY (FINAL): YELLOW OWNER COPY (INITIAL): PINK