IREDELL COUNTY HEALTH DEPARTMENT

STATESVILLE 704-878-5305 MOORESVILLE 704-664-5281

IMPROVEMENT PERMIT / AUTHORIZATION TO CONSTRUCT / OPERATION PERMIT / EXISTING SYSTEM INSPECTION

PERMIT# REPAIR PIN# DATE 2-21-00

OWNER OR CONTRACTOR JOSEPH P. THOMPSON PHONE: Business Home 876-4161

ADDRESS 3579 WILKESBORO Hwy, STATESVILLE, NC 28625

LOCATION NC 115 N, TL PRIVATE DRIVE JUST BEFORE SNOW CREEK (BRIDGE), 1ST DRIVE ON (L)

SUBDIVISION BLOCK / SECTION LOT LOT AREA ~3 ACRES SITE CLASS PS DESIGN FLOW 360 L.T.A.R. EXISTING

Septic Tank: EXISTING Gallons: STB Date

Pump Tank: Gallons: PT Date

Pump Make: Model Serial No.

Nitrification Field: No Fields 1 Square Feet 720 Linear Feet 120

No Lines 1 BED Trench Width 6FT. Max Trench Bottom Depth 36" Gravel Depth (18")

☐ New System ☑ Repair System Type: I (II) III IV V VI

System Description: CONVENTIONAL GRAVITY

Repair System Description: CONV. GRAVITY

Maintenance Agreement Required: ☐ Yes ☑ No

☐ House/Mod. Home No. Bedrooms 3

☐ Mobile Home No. Bathrooms 2

☐ Business No. Employees

☐ Other


☐ Slab ☑ Crawl Space ☐ Basement w/plumbing ☐ Basement wo/plumbing

Water Supply: ~~Individual~~ ☐ Public ☐ Community WELL


Comments/Conditions: INSTALL NEW 6' X 120' BED AS FLAGGED ON SITE USING 18" STONE
(E) THIS PERMIT SERVES AS NOTICE OF VIOLATION - SYSTEM TO BE REPAIRED BY 3-25-00

Comments/Conditions: NEW SANITARY TEE INSTALLED IN SEPTIC TANK

INITIAL SITE SKETCH

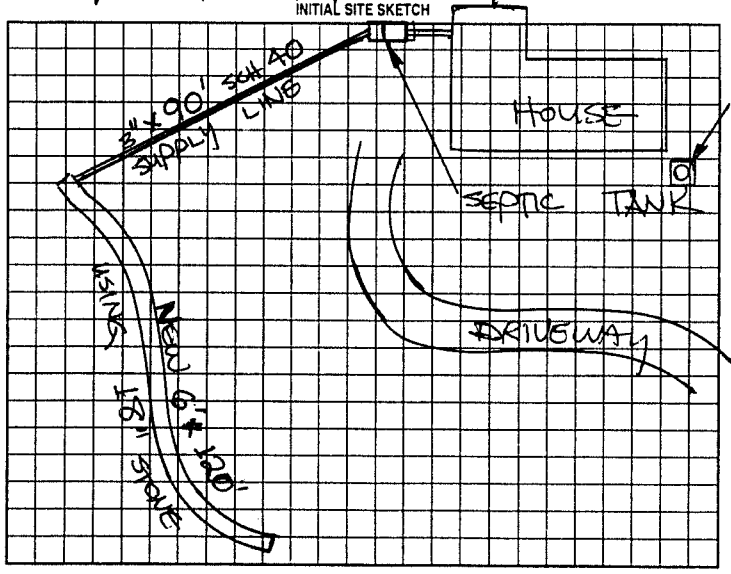

AS BUILT SKETCH

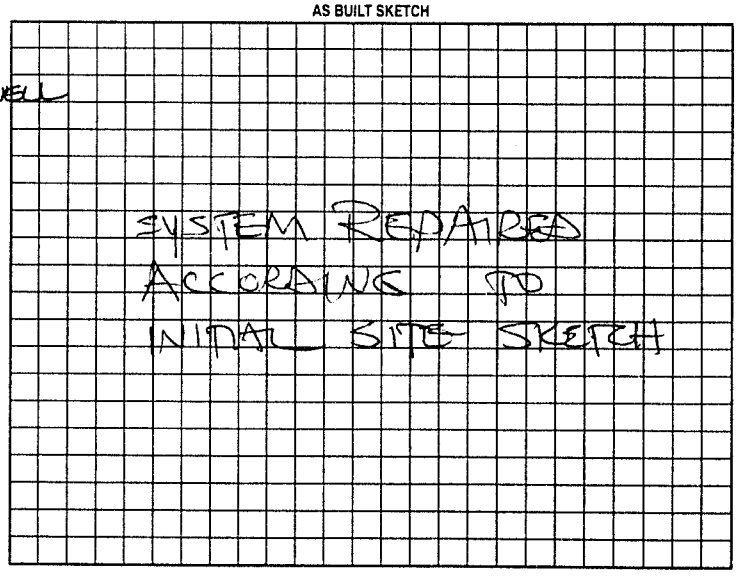

Permit can be suspended or revoked if any false information is supplied toward securing the permit/any unauthorized changes are made to the site/any unauthorized changes are made in the installation of the system. Improvement Permit with plat valid without expiration. Improvement Permit with site plan valid for sixty months. Authorization to Construct is valid for a period equal to that of Improvement Permit – not to exceed sixty months.

Signed: X Joseph P. Thompson date 2-21-00 Installed by: RENT GAULHER

Improvement Permit by: STEVE HEDRICK date 2-21-00 Operation Permit by: STEVE HEDRICK date 3-16-00

Authorization to Construct by: STEVE HEDRICK date 2-21-00 Existing System Inspection by: date

HEALTH DEPT. COPY: WHITE OWNER COPY (FINAL): YELLOW OWNER COPY (INITIAL): PINK