IREDELL COUNTY HEALTH DEPARTMENT

STATESVILLE 704-878-5305 MOORESVILLE 704-664-5281

IMPROVEMENT PERMIT / CERTIFICATE OF COMPLETION / OPERATION PERMIT / EXISTING SYSTEM INSPECTION

PROPERTY DESCRIPTION NO. 23142 DATE 2-22-96 TAX MAP NO 14F-A-68 Watershed ☐ Yes ☑ No

OWNER OR CONTRACTOR ENOCH FLOOD PHONE Business Home 539-4150

ADDRESS P.O. BOX 61, UNION GROVE, NC 28689

LOCATION NC 115 N, TL HILL DAIRY ROAD, CONTINUE KING LANE TO END, DRIVE ON (L)

SUBDIVISION BLOCK / SECTION LOT LOT AREA 3.8 AC± SITE CLASS PS DESIGN FLOW 360 L.T.A.R. 0.2 GPD/FT²

Septic Tank: 1000 Gallons. STB 794 Date 2-16-96

Pump Tank: Gallons: PT Date

Pump Make: Model Serial No

Nitrification Field: No Fields 1 Square Feet 1800 Linear Feet 600

No Lines 4 Trench Width 36 Max Trench Bottom Depth 36" Gravel Depth 12"

☑ New System ☐ Repair System Type: I II III IV V VI

System Description: CONVENTIONAL GRAVITY

Repair System Description: CONVENTIONAL PUMP

Maintenance Agreement Required Yes ☑ No

Slab ☑ Crawl Space Basement w/plumbing Basement wo/plumbing

☐ House/Mod. Home No Bedrooms 3

☑ Mobile Home No. Bathrooms 2

☐ Business No Employees

Other


Water Supply: ☑ Individual ☐ Community ☐ Public

Comments: ① KEEP SYSTEM MINIMUM 100' FROM WELL ② USE THREE FLOW DIVIDER TEES TO ACHIEVE EQUAL DIST. INTO FOUR 150' LINES ③ INSTALL SUBSURFACE INTERCEPT DITCH MINIMUM 4 FEET DEEP TO DAYLIGHT AS SHOWN.


Comments: TANK & DRAIN LINES INSPECTED 4/3/96

SUBSURFACE INTERCEPT DITCH INSTALLED 4-10-96 BUT NOT INSPECTED

INITIAL SITE SKETCH

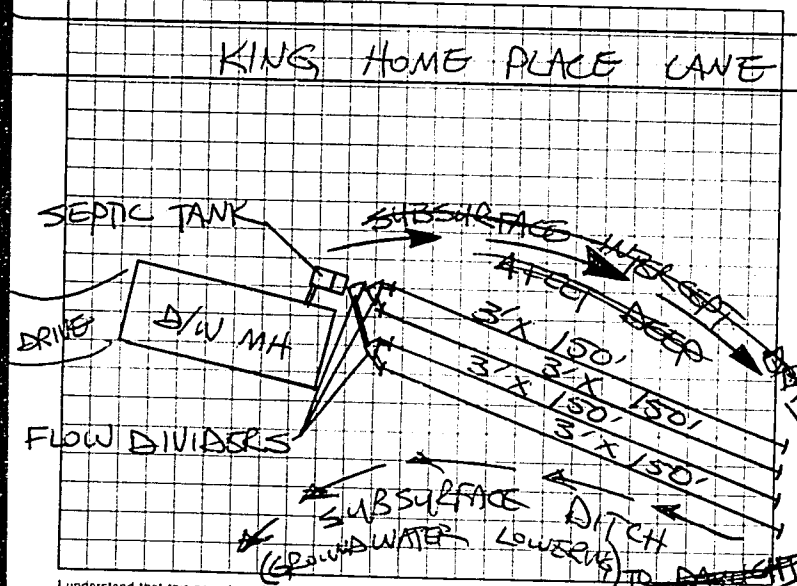

AS BUILT SKETCH

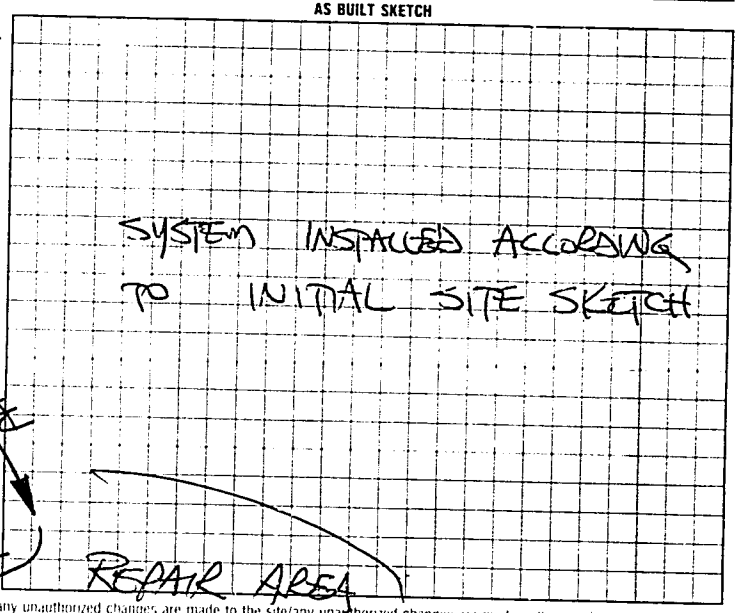

I understand that this permit can be suspended or revoked if any false information is supplied toward securing permit, any unauthorized changes are made to the site, any unauthorized changes are made in the installation of the system.

AUTHORIZATION TO CONSTRUCT IS VALID FIVE (5) YEARS FROM DATE OF ISSUANCE, IMPROVEMENT PERMIT HAS NO EXPIRATION DATE

Signed Certificate of Completion (agent)

Improvement Permit by STEVE HEDRICK date 2-22-96

AUTHORIZATION TO CONSTRUCT

Existing System Inspection by STEVE HEDRICK date 2-22-96

Installed by A-1 BACKHOE

Certificate of Completion by date

Operation Permit by STEVE HEDRICK date 4-11-96

HEALTH DEPT COPY WHITE INSPECTION COPY (FINAL) GREEN OWNER COPY (FINAL) YELLOW INSPECTION COPY (INITIAL) PINK OWNER COPY (INITIAL) GOLD