IREDELL COUNTY HEALTH DEPARTMENT

STATESVILLE 704-878-5305 MOORESVILLE 704-664-5281

IMPROVEMENT PERMIT / AUTHORIZATION TO CONSTRUCT / OPERATION PERMIT / EXISTING SYSTEM INSPECTION

Billy M. Fink

PERMIT# 125697 PIN# 4728-34-9326 31-9911 DATE 12-10-04

OWNER OR CONTRACTOR Clayton Homes - Statesville PHONE: Business (704) 873-2547 Home

ADDRESS 2026 North Side Drive Statesville N.C. 28677

LOCATION Hwy 115 N, Right on Crider Rd, on corner of Crider + Wilkesboro Hwy (115N)

SUBDIVISION - BLOCK / SECTION LOT - LOT AREA 1.1234 Ac SITE CLASS. PS DESIGN FLOW 360 L.T.A.R. .35 gpd

Septic Tank: 4000 Gallons; STB Date

Pump Tank: Gallons; PT Date

Pump Make: Model Serial No.

Nitrification Field: No Fields 1 Square Feet 1035 Linear Feet 345

No Lines 5 Trench Width Max Trench Bottom Depth Gravel Depth 12"

~~Existing~~ System ☐ Repair System Type: I, II, III, IV, V, VI

System Description: Gravity / Conventional

Repair System Description: Gravity / Conventional

Maintenance Agreement Required: ☐ Yes ☒ No

☒ House/Mod. Home No. Bedrooms 3

☐ Mobile Home No. Bathrooms

☐ Business No. Employees

☐ Other

☐ Slab ☒ Crawl Space ☐ Basement w/plumbing ☐ Basement wo/plumbing

Water Supply: ☒ Individual ☐ Public ☐ Community

Comments:/Conditions:


Comments:/Conditions:

- Septic System okay at time of Inspection.
- maintain proper setbacks when placing new Home on site
- keep Vechicles Traffic off Septic System

(Ref: Billy Fink 5/7/93)

INITIAL SITE SKETCH

AS BUILT SKETCH (Not to Scale)

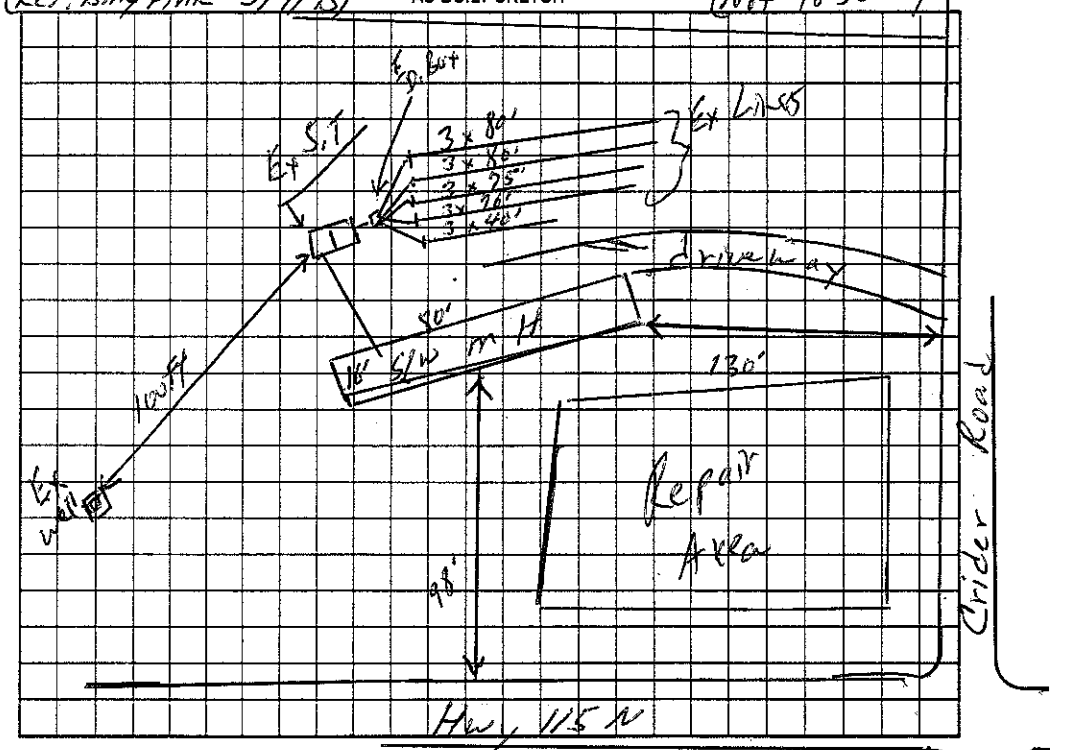

Permit can be suspended or revoked if any false information is supplied toward securing the permit/any unauthorized changes are made to the site/any unauthorized changes are made in the installation of the system. Improvement Permit with plat valid without expiration. Improvement Permit with site plan valid for sixty months. Authorization to Construct is valid for a period equal to that of Improvement Permit – not to exceed sixty months.

Signed: date Installed by:

Improvement Permit by: date Operation Permit by: date

Authorization to Construct by: date Existing System Inspection by: William Johnson date 12/10/04

HEALTH DEPT. COPY: WHITE OWNER COPY (FINAL): YELLOW OWNER COPY (INITIAL): PINK

Farm House Rd