IREDELL COUNTY HEALTH DEPARTMENT

STATESVILLE 704-878-5305 MOORESVILLE 704-664-5281

IMPROVEMENT PERMIT / AUTHORIZATION TO CONSTRUCT / OPERATION PERMIT / EXISTING SYSTEM INSPECTION

PERMIT# REPAIR PIN# DATE 4-1-99

OWNER OR CONTRACTOR ROBERT INSCORE PHONE: Business Home 876-0316

ADDRESS 3310 WILKESBORO HIGHWAY, STATESVILLE, NC 28625

LOCATION NC 115 N, CROSS S. YADKIN RIVER, BEHIND 2ND BRICK HOUSE ON RIGHT AT BOX # 3322

SUBDIVISION BLOCK / SECTION LOT LOT AREA LIMITED SITE CLASS PS DESIGN FLOW 240 L.T.A.R. EXISTING

Septic Tank: EXISTING Gallons: STB Date

Pump Tank: Gallons: PT Date

Pump Make: Model Serial No.

Nitrification Field: No Fields 1 Square Feet 225 Linear Feet 75

No Lines ONE Trench Width 36" Max Trench Bottom Depth 36 Gravel Depth 24"

☐ New System ☑ Repair System Type: I II III IV V VI

System Description: CONV. GRAVITY

Repair System Description: CONVENTIONAL GRAVITY

Maintenance Agreement Required: Yes ☑ No

☐ Slab ☑ Crawl Space ☐ Basement w/plumbing ☐ Basement wo/plumbing

☑ House/Mod. Home No. Bedrooms 2

☐ Mobile Home No. Bathrooms 1

☐ Business No. Employees


☐ Other

Water Supply: ☑ Individual ☐ Public ☐ Community WELLS


Comments/Conditions: ① INSTALL NEW DISTRIBUTION BOX AND NEW 3' x 75' LINE USING 24 INCHES STONE ② THIS PERMIT SERVES AS NOTICE OF VIOLATION

Comments/Conditions:

INITIAL SITE SKETCH

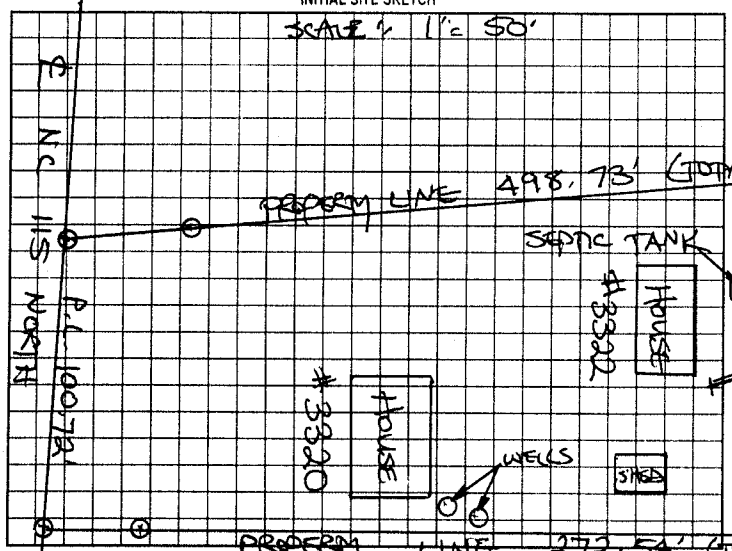

AS BUILT SKETCH

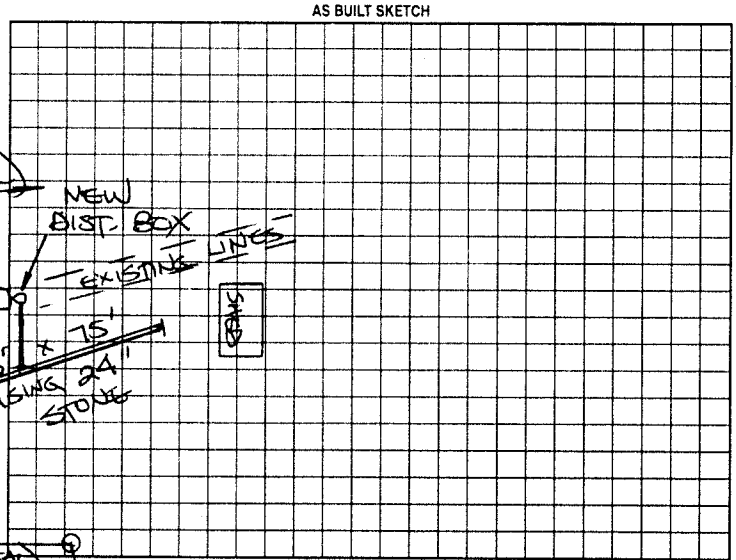

Permit can be suspended or revoked if any false information is supplied toward securing the permit/any unauthorized changes are made to the site/any unauthorized changes are made in the installation of the system. Improvement Permit with plat valid without expiration. Improvement Permit with site plan valid for sixty months. Authorization to Construct is valid for a period equal to that of Improvement Permit – not to exceed sixty months.

Signed: Robert Inscore date 4-1-99 Installed by: James Hudler

Improvement Permit by: STEVE HEDRICK date 4-1-99 Operation Permit by: Mark Craft RS date 4-16-99

Authorization to Construct by: STEVE HEDRICK date 4-1-99 Existing System Inspection by: date

HEALTH DEPT COPY WHITE OWNER COPY (FINAL) YELLOW OWNER COPY (INITIAL) PINK