IREDELL COUNTY HEALTH DEPARTMENT

STATESVILLE 704-878-5305 MOORESVILLE 704-664-5281

IMPROVEMENT PERMIT / CERTIFICATE OF COMPLETION / OPERATION PERMIT / EXISTING SYSTEM INSPECTION

PROPERTY DESCRIPTION NO. 16490 DATE 6/10/93 TAX MAP NO. 9P-A-69

OWNER OR CONTRACTOR CLAYTON BROOKS PHONE: Business 872-3649 Home 876-6344

ADDRESS RT. 11 BOX 369 STATESVILLE, NC 28677

LOCATION NC 115 N, TR FINK ROAD (SR 1690), MH AT END BEHIND EXISTING HOUSE

SUBDIVISION _____ BLOCK / SECTION _____ LOT _____ LOT AREA 2.81 ACRE SITE CLASS PS L.T.A.R. 0.40 GPD/FT²

Water Supply: ☑ Individual ☐ Community ☐ Public

Septic Tank: 1000 Gallons; STB 1012 Date 4/14/93

Pump Tank: _____ Gallons; PT _____ Date _____

Nitrification Field: No Fields 1 Square Feet 900 Linear Feet 300

No Lines 3 Trench Width 36" Trench Depth ≤36" Gravel Depth 12"

☑ New System ☐ Repair System Type: I, II, III, IV, V, VI

System Description: CONV. GRAVITY

Repair System Description: CONV. GRAVITY

Maintenance Agreement Required: ☐ Yes ☑ No

☐ House/Mod. Home ☑ Mobile Home ☐ Business ☐ Other

No. Bedrooms 3 No. Bathrooms 2 No. Employees _____

☐ Slab ☑ Crawl Space ☐ Basement w/plumbing ☐ Basement wo/plumbing

Garbage Disposal: ☐ Yes ☑ No


Auto. Dishwasher: ☑ Yes ☐ No

Auto. Washing Machine: ☑ Yes ☐ No

Other _____

Comments _____

INITIAL SITE SKETCH

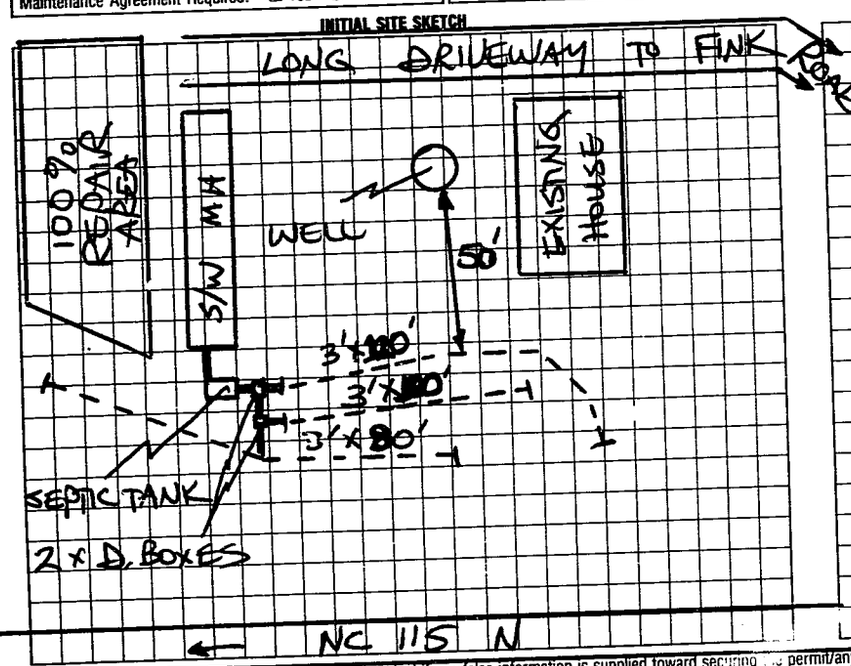

AS BUILT SKETCH

INSTALLED ACCORDING TO INITIAL SITE SKETCH

I understand that this permit can be suspended or revoked if any false information is supplied toward securing this permit/any unauthorized changes are made to the site/any unauthorized changes are made in the installation of the system.

Improvement Permit is valid for 60 months from date of issuance.

Signed: Clayton J. Brooks

Improvement Permit by: STEVE HEDRICK date 6/10/93

Existing System Inspection by: _____ date _____

Installed by: JAMES HUDLER

Certificate of Completion by: STEVE HEDRICK date 6/22/93

Operation Permit by: _____ date _____

HEALTH DEPT. COPY: WHITE INSPECTION COPY (FINAL): GREEN OWNER COPY (FINAL): YELLOW INSPECTION COPY (INITIAL): PINK OWNER COPY (INITIAL): GOLD