IREDELL COUNTY HEALTH DEPARTMENT

STATESVILLE 704-878-5305 MOORESVILLE 704-664-528

IMPROVEMENT PERMIT / AUTHORIZATION TO CONSTRUCT / OPERATION PERMIT / EXISTING SYSTEM INSPECTION

PERMIT# 094003 PIN# 4728407594 DATE 2/27/01

OWNER OR CONTRACTOR Oakwood Homes PHONE: Business (704)528-4516 Home —

ADDRESS 1042 Charlotte Hwy Troutman, NC. 28166

LOCATION Hwy 115 N., (R) Ender, Turn Right, @ End of road on right

SUBDIVISION — BLOCK / SECTION — LOT — LOT AREA 3.9 Acres SITE CLASS 75 DESIGN FLOW 360 L.T.A.R. 3000/55²

Septic Tank: 4000 Gallons: STB 779 Date 12-30-00

Pump Tank: — Gallons: PT — Date —

Pump Make: — Model — Serial No. —

Nitrification Field: No Fields 1 Square Feet 1200 Linear Feet 400

No Lines 4@100' Trench Width 36" Max Trench Bottom Depth 36" Gravel Depth 12"

X New System ☐ Repair System Type: ☒ II, III, IV, V, VI

System Description: Gravity Conventional

Repair System Description: Pump, Conventional

Maintenance Agreement Required: ☐ Yes X No

☐ House/Mod. Home ☒ Mobile Home ☐ Business ☐ Other

No. Bedrooms 3 No. Bathrooms 2 No. Employees —


☐ Slab ☐ Crawl Space ☐ Basement w/plumbing ☐ Basement wo/plumbing

Water Supply: ☒ Individual ☐ Public ☐ Community

Comments/Conditions: ① Do not install when wet ② Keep System 100 ft from well ③ Install lines on contour

Comments/Conditions: - Gray Filter Installed - Septic Tank Marker Installed

INITIAL SITE SKETCH

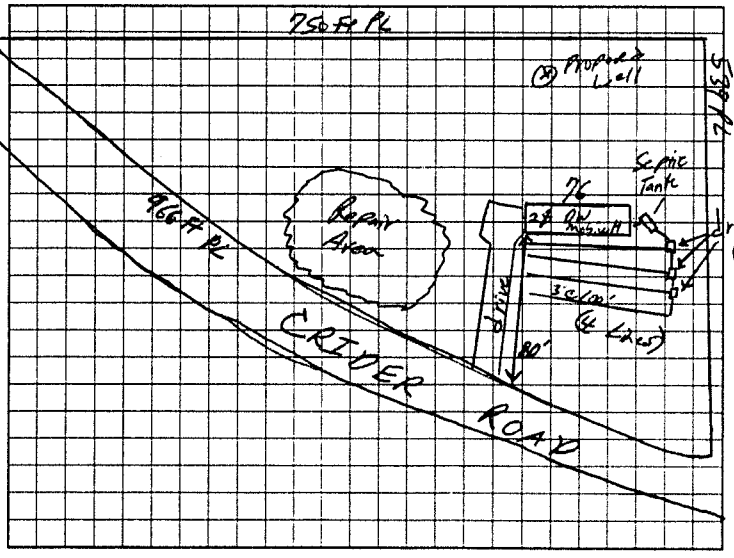

AS BUILT SKETCH

Septic System Installed as designed

Permit can be suspended or revoked if any false information is supplied toward securing the permit/any unauthorized changes are made to the site/any unauthorized changes are made in the installation of the system. Improvement Permit with plat valid without expiration. Improvement Permit with site plan valid for sixty months. Authorization to Construct is valid for a period equal to that of Improvement Permit - not to exceed sixty months.

Signed: [signature] date 3/2/01 Installed by: Craig Thompson

Improvement Permit by: William O. Johnson RSI date 2/27/01 Operation Permit by: William O. Johnson LSI date 3/13/01

Authorization to Construct by: William O. Johnson RSI date 2/27/01 Existing System Inspection by: — date —

HEALTH DEPT. COPY: WHITE OWNER COPY (FINAL): YELLOW OWNER COPY (INITIAL): PINK