IREDELL COUNTY HEALTH DEPARTMENT

STATESVILLE 704-878-5305 MOORESVILLE 704-664-5281

IMPROVEMENT PERMIT / AUTHORIZATION TO CONSTRUCT / OPERATION PERMIT / EXISTING SYSTEM INSPECTION

PERMIT# 122873 PIN# 4728-41-1934 DATE 9/7/04

OWNER OR CONTRACTOR Office Branham PHONE: Business — Home (704) 546-5596

ADDRESS 136 Crider Rd Statesville N.C. 28625

LOCATION Hwy 115 N, (R) Crider Road, lot on ~~left~~ left before road turns

SUBDIVISION — BLOCK / SECTION — LOT — LOT AREA 1.05 Ac. SITE CLASS PS DESIGN FLOW 360 L.T.A.R. .35 g/d/ft²

Septic Tank: 1,000 Gallons; STB 1012 Date 7-16-04
Pump Tank: — Gallons; PT — Date —
Pump Make: — Model — Serial No. —
Nitrification Field: No Fields 1 Square Feet Extra 1029 Linear Feet 190
No Lines 5 Trench Width 24" Max Trench Bottom Depth 36" Gravel Depth ~~6~~ 6"

☒ New System ☐ Repair System Type: I, II, (III), IV, V, VI
System Description: Gravity 50% Reduction
Repair System Description: Pump LPP (Large Pump Pressure)
Maintenance Agreement Required: ☐ Yes ☒ No


☐ House/Mod. Home No. Bedrooms 3
☒ Mobile Home No. Bathrooms 2
☐ Business No. Employees —
☐ Other —
☐ Slab ☒ Crawl Space ☐ Basement w/plumbing ☐ Basement wo/plumbing

Water Supply: ☒ Individual ☐ Public ☐ Community


Comments/Conditions: (1) Install 40 Panels w/ ~~30~~ 40 fms of Sand (Sand Supplier 5015) (3) Install 3 Lines - 45ft long with 10 panels/liner and 2 Lines (22.5ft) with Flow divider tee with 5 panels/line. (3) Keep well 100 ft from septic system + repair (4) Fill must be removed from repair area, before installing repair

Comments/Conditions: (1) YELLOW TUFF-TITE FILTER (2) STAND PIPE 6" ABOVE GRADE (3) "SPACE INVADER" SEAL

INITIAL SITE SKETCH (Not to Scale)

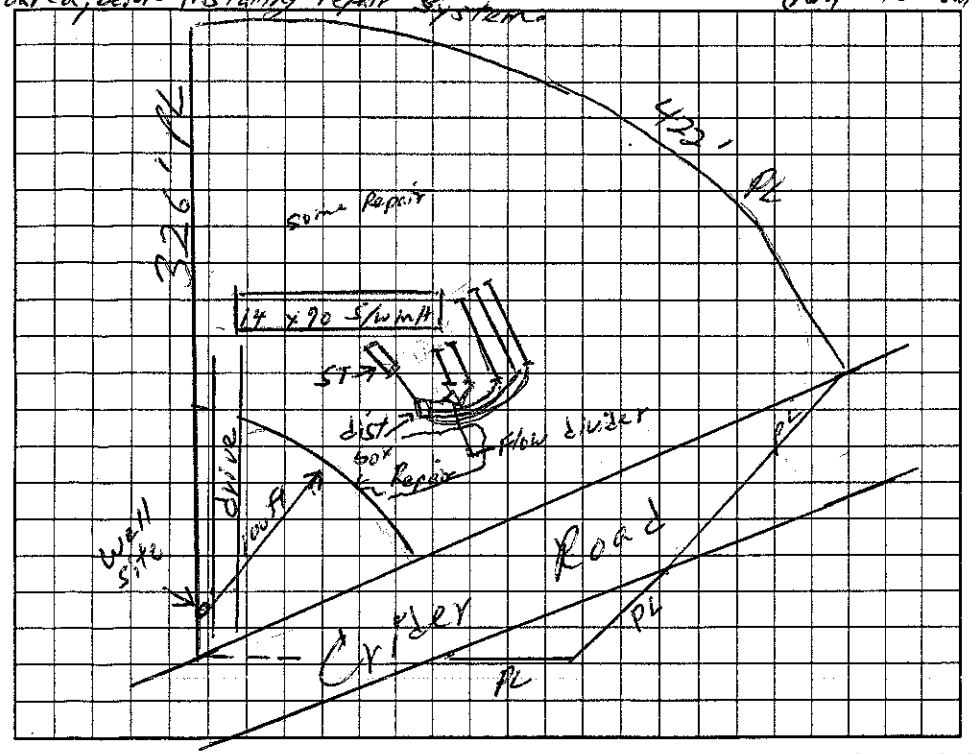

AS BUILT SKETCH

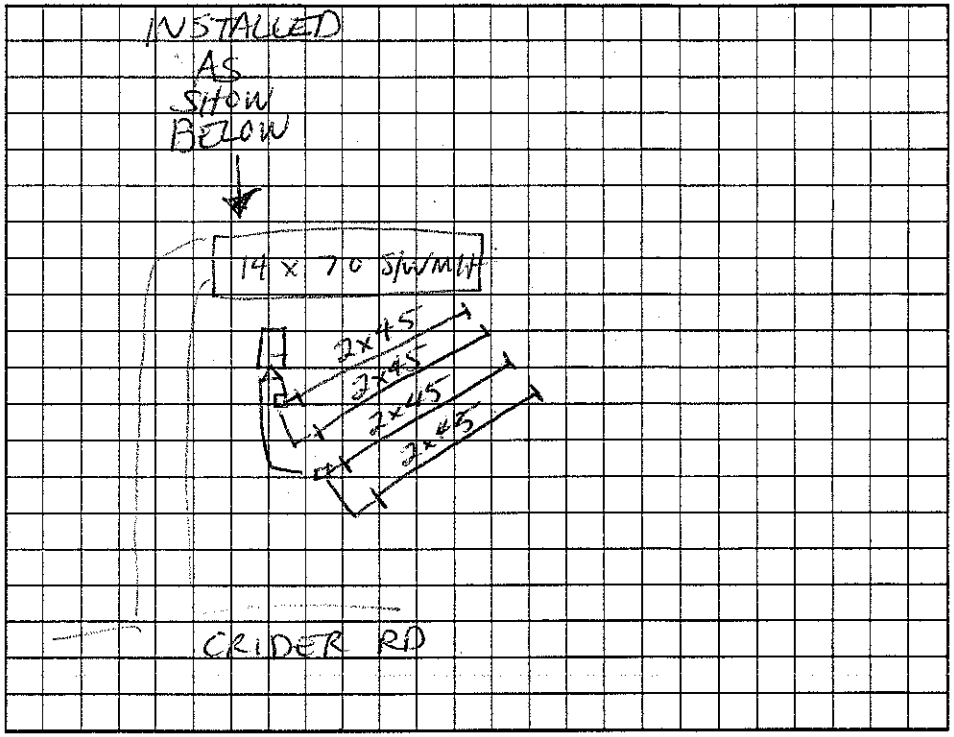

Permit can be suspended or revoked if any false information is supplied toward securing the permit/any unauthorized changes are made to the site/any unauthorized changes are made in the installation of the system. Improvement Permit with plat valid without expiration. Improvement Permit with site plan valid for sixty months. Authorization to Construct is valid for a period equal to that of Improvement Permit – not to exceed sixty months.

Signed: Office Branham date —

Improvement Permit by: William O. Johnson date 9/7/04

Authorization to Construct by: William O. Johnson date 9/7/04

Installed by: A-1 BACKHOE

Operation Permit by: Christy M. Stone RS LSS date 1-28-05

Existing System Inspection by: — date —

HEALTH DEPT. COPY: WHITE OWNER COPY (FINAL): YELLOW OWNER COPY (INITIAL): PINK