IREDELL COUNTY HEALTH DEPARTMENT

STATESVILLE 704-878-5305 MOORESVILLE 704-664-5281

56532

IMPROVEMENT PERMIT / CERTIFICATE OF COMPLETION / OPERATION PERMIT / EXISTING SYSTEM INSPECTION

PROPERTY DESCRIPTION NO. 21489 DATE 7-3-95 TAX MAP NO. 9P-A-62 Watershed: ☐ Yes ☑ No

OWNER OR CONTRACTOR MICHAEL LYNN HOOPER, JR PHONE: Business Home 876-3332

ADDRESS 162 CRIDER RD, STATESVILLE, NC 28677

LOCATION NC 115 N, TR CRIDER RD, TR ② YIELD TR PRIVATE DRIVE AT BOX #162

SUBDIVISION BLOCK / SECTION LOT LOT AREA 6.3 AC SITE CLASS. PS DESIGN FLOW 360 L.T.A.R. 0.3 GAD/FT²

Septic Tank: 1000 Gallons: STB 1012 Date 6-17-95

Pump Tank: Gallons: PT Date

Pump Make Model Serial No

Nitrification Field: No Fields 1 Square Feet 1200 Linear Feet 400

No Lines 5 Trench Width 36" Max Trench Bottom Depth 30" Gravel Depth 12"

☑ New System ☐ Repair System Type: I, II, III, IV, V, VI

System Description: CONV. GRAVITY

Repair System Description: CONV. GRAVITY

Maintenance Agreement Required: ☐ Yes ☑ No

☐ House/Mod. Home ☑ Mobile Home ☐ Business ☐ Other

No. Bedrooms 3 No. Bathrooms 2 No. Employees


☐ Slab ☑ Crawl Space ☐ Basement w/plumbing ☐ Basement wo/plumbing

Water Supply: ☑ Individual ☐ Community ☐ Public WELL

Comments: ① KEEP SYSTEM MINIMUM 5' FROM MH, 10' FROM PROPERTY LINE, 100 FROM WELL ② INSTALL LINES ON CONTOUR, NO DEEPER THAN 30", 9' MINIMUM APART ON CENTERS.

Comments:

INITIAL SITE SKETCH

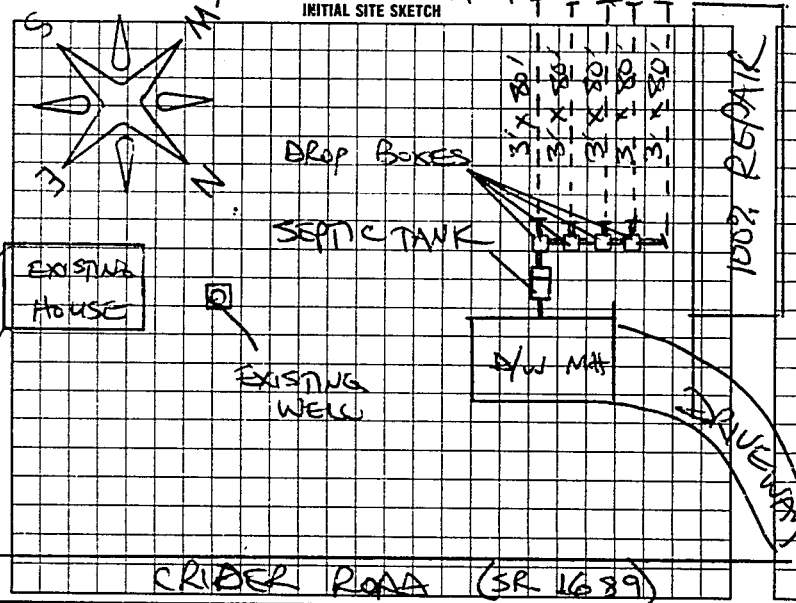

AS BUILT SKETCH

SYSTEM INSTALLED ACCORDING TO INITIAL SITE SKETCH

I understand that this permit can be suspended or revoked if any false information is supplied toward securing the permit/any unauthorized changes are made to the site/any unauthorized changes are made in the installation of the system. Improvement Permit is valid for 60 months from date of issuance.

Signed: X Eugenia J Hooper

Improvement Permit by: STEVE HEDRICK date 7-3-95

Existing System Inspection by: date

Installed by: KENNY PEARSON

Certificate of Completion by: STEVE HEDRICK date 8-11-95

Operation Permit by: date

HEALTH DEPT. COPY: WHITE INSPECTION COPY (FINAL): GREEN OWNER COPY (FINAL): YELLOW INSPECTION COPY (INITIAL): PINK OWNER COPY (INITIAL): GOLD

0007 32