PERMIT # 169317 PIN # 4728-41-6434

IREDELL COUNTY HEALTH DEPARTMENT – *Environmental Health Division*

Statesville Office 704-878-5305 Mooresville Office 704-660-3625

PRIVATE DRINKING WATER WELL PERMIT

Type of Permit (circle one) (New) Repair Abandonment

APPLICANT INFORMATION

Jerry Kump | 4317 N. Hwy 16 STE "C" Denver, NC | (704) 489-1158

Name | Full Address | Telephone #

PROPERTY INFORMATION


115N TR CRIDER Rd. ON Rt.

Directions to Site

150 Crider Rd. Statesville, NC.

Physical location of proposed well (street address) Subdivision Lot #

Initial Site Sketch

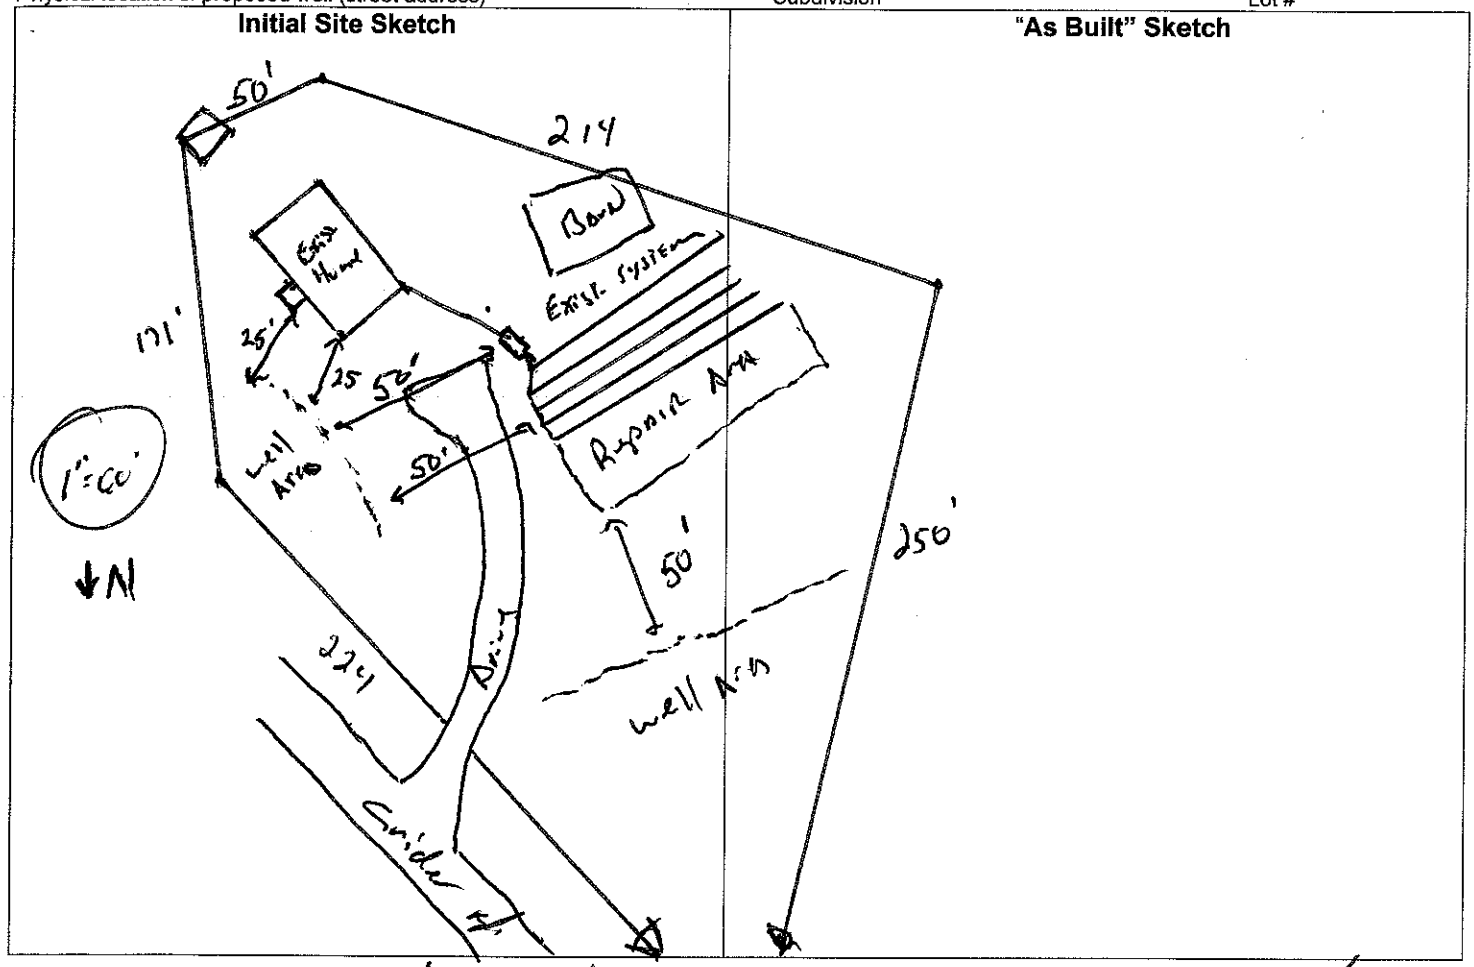

"As Built" Sketch

Permit Conditions/ Comments: Keep well 50' from septic and septic repair areas / Keep 25' from and building Foundation /

Well Permit Issued By: [signature], R.S. **Date:** 17 November 2011

(Permit is valid for 5 years from date issued. This permit may be revoked if it is determined there has been a material change in any fact or circumstance upon which the permit is issued. Actions of the employees of the Iredell County Health Department shall in no way be taken as a guarantee that this well will produce water of any particular quantity or quality or for any amount of time. Employees of the Iredell County Health Department assume no liability for any damages, either direct or consequential which may be caused by this well.)

Well GPS Coordinates Lat: _____ **Long:** _____ **Well Contractor** Advanced Well **Contractor Cert #** 3232 ©

Grout Inspection By: [signature], R.S. **Date:** 1 Dec. 11 **or Certification for Grouting Not Witnessed**

by Dept _____ **Date:** _____ **Well Head Inspection** (check when completed) Grout to Ground Surface ☐

Well Contractor ID Plate ☑ Pump Installer ID Plate ☑ Sample Port ☑ Access Port / Vent ☑ Well Seal ☑ Well Head 12 inches / Pit less Adaptor 8 inches above grade ☑ ©

Well Head Inspection By: L. COOK **Date:** 4-16-12

Certificate of Completion by: L. COOK **Date:** 4/6/12 **Water Samples By:** L. COOK **Date:** 4-16-12

Attachments: Form GW-1a (***required except for abandonment***) ☑ Form GW 30 ☐ Water Sample Results ☐ Plat ☐

Health Dept. Copy - White Applicant Certificate of Completion - Yellow Applicant Well Construction Permit - Pink