FILED 11/4 to Bonny

IREDELL COUNTY HEALTH DEPARTMENT

Environmental Health Division

Statesville Office 704-878-5305 Mooresville Office 704-660-3625

APPLICATION FOR PRIVATE DRINKING WATER WELL PERMIT

704 489-1158

KUMP INVESTMENTS INC 4317 NHWY 16 STE "C" DENVER NC 28037

Applicant Name | Full Address | Phone Number

JERRY KUMP 4317 N.HWY 16 STE "C" DENVER NC 28037 828-312-0143

Name of Owner / Authorized Agent | Full Address | Phone Number

150 CRIDER RD STATESVILLE NC 286


Property Street Address | Subdivision | Lot Number

4728-41-6434 Home

Parcel Identification Number (PIN) | Intended Use of Property | Type of Well Permit (New, Repair, Abandonment)

All site characteristics such as existing or permitted sewage disposal systems, easements or rights of way, existing wells or springs, surface water or designated wetlands, chemical or petroleum storage tanks, landfills, waste storage, known underground contamination and any other characteristics or activities on the property or adjacent properties that could impact groundwater quality or suitability of the site for well construction must be identified on the site plan sketch below.

SITE PLAN SKETCH

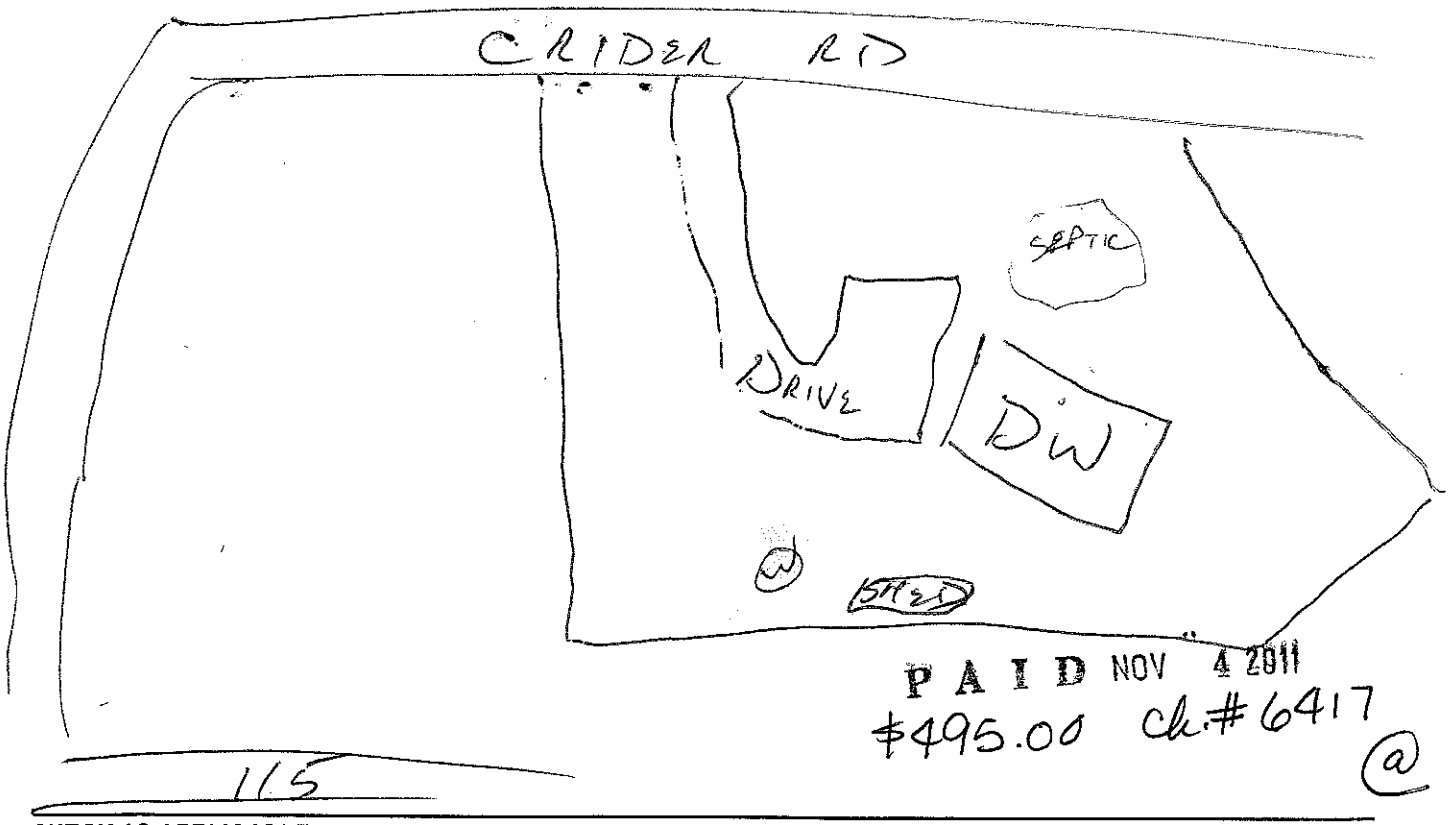

PAID NOV 4 2011
$495.00 Ck.# 6417

115

CHECK AS APPLICABLE:

____ There are current or pending restrictions regarding groundwater use as specified in GS 87-88(a)

____ There is a variance regarding well construction or location issued under 15A NCAC 02C .0118.

By signing below I acknowledge that the information provided herein is true, complete and correct. Furthermore, I grant authorized county and state officials right of entry to conduct necessary inspections to determine compliance with applicable laws and rules. I understand I am solely responsible for the proper identification and labeling of all property lines and corners and making the site accessible so that a complete site investigation can be performed.

SIGNATURE OF OWNER OR AUTHORIZED AGENT | DATE 11/4/11

Health Department Copy - White | Applicant Copy - Yellow

Applicant ~~does~~ not concerned with well location.

IREDELL COUNTY HEALTH DEPARTMENT

STATESVILLE 704-878-5305 MOORESVILLE 704-664-5281

56532

IMPROVEMENT PERMIT / CERTIFICATE OF COMPLETION / OPERATION PERMIT / EXISTING SYSTEM INSPECTION

PROPERTY DESCRIPTION NO. 21489 DATE 7-3-95 TAX MAP NO. 9P-A-62 Watershed: ☐ Yes ☒ No

OWNER OR CONTRACTOR MICHAEL LYNN HOOPER, JR PHONE: Business Home 876-3332

ADDRESS 162 CRIDER RD, STATESVILLE, NC 28677

LOCATION NC 115 N, TR CRIDER RD, TR ⓐ YIELD TR PRIVATE DRIVE AT BOX #162

SUBDIVISION BLOCK / SECTION LOT LOT AREA 6.3 AC SITE CLASS. PS DESIGN FLOW 360 L.T.A.R. 0.3 GPD/FT²

Septic Tank: 1000 Gallons: STB 1012 Date 6-17-95

Pump Tank: Gallons: PT Date

Pump Make: Model Serial No.

Nitrification Field: No Fields 1 Square Feet 1200 Linear Feet 400

No Lines 5 Trench Width 36" Max Trench Bottom Depth 30" Gravel Depth 12"

☒ New System ☐ Repair System Type: I, II, III, IV, V, VI

System Description: CONV. GRAVITY

Repair System Description: CONV. GRAVITY

Maintenance Agreement Required: ☐ Yes ☒ No

☐ House/Mod. Home ☒ Mobile Home ☐ Business ☐ Other

No. Bedrooms 3 No. Bathrooms 2 No. Employees


☐ Slab ☒ Crawl Space ☐ Basement w/plumbing ☐ Basement wo/plumbing

Water Supply: ☒ Individual ☐ Community ☐ Public WELL

Comments: ① KEEP SYSTEM MINIMUM 5' FROM MH, 10' FROM PROPERTY LINE, 100' FROM WELL ② INSTALL LINES ON CONTOUR, NO DEEPER THAN 30", 9' MINIMUM APART ON CENTERS.

Comments:

INITIAL SITE SKETCH

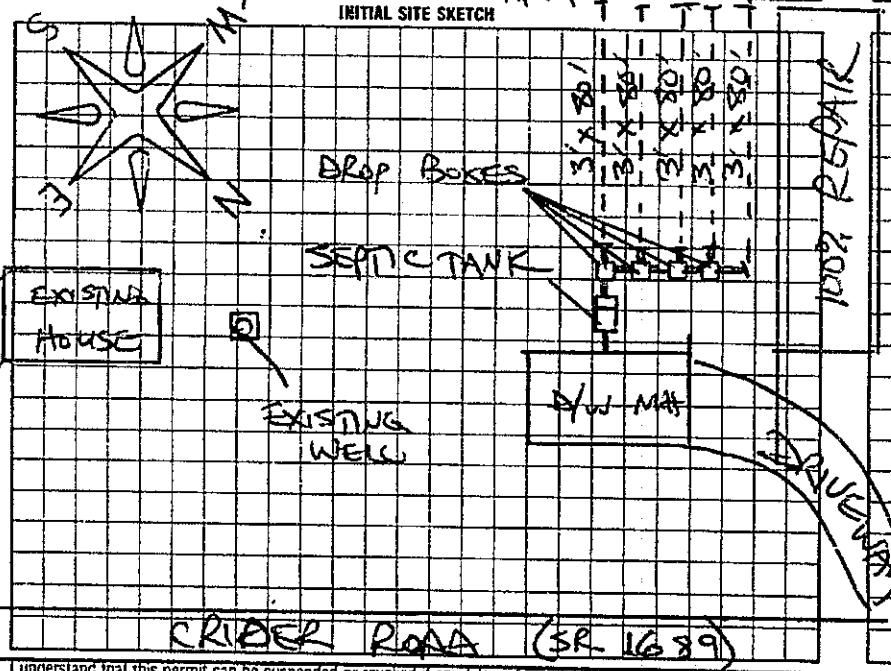

AS BUILT SKETCH

SYSTEM INSTALLED ACCORDING TO INITIAL SITE SKETCH

I understand that this permit can be suspended or revoked if any false information is supplied toward securing the permit/any unauthorized changes are made to the site/any unauthorized changes are made in the installation of the system. Improvement Permit is valid for 60 months from date of issuance.

Signed: X Eugenia D Hooper

Improvement Permit by: STEVE HERRICK date 7-3-95

Existing System Inspection by: date

Installed by: KENNY PEARSON

Certificate of Completion by: STEVE HERRICK date 8-11-95

Operation Permit by: date

HEALTH DEPT. COPY WHITE INSPECTION COPY (FINAL) GREEN OWNER COPY (FINAL) YELLOW INSPECTION COPY (INITIAL): PINK OWNER COPY (INITIAL): GOLD

0 0 7 3 2

Iredell County
Planning & Enforcement
349 N. Center St. PO Box 788
Statesville, NC 28687
704-878-3113

Permit Number: 169317WE

Printed: 11/4/2011

Master #: 169317

Associated Permits:
169317WE Well

Applicant

Name: Kump Investments Inc.
Address: 4317 N HWY 16 STEC
Denver, NC 28037

Phone: 704-489-1158

Parcel

Parcel Number: 4728416434.000
Address: 150 Crider Rd.
Statesville, NC 28625
Subdivision:

Zoning: RA
Township: 1000
Area:
Lot(s):

Directions to Parcel: WILKESBORO HWY TO CRIDER

Owners

Name: Kump Investments Inc.
Address: 4317 N HWY 16 STEC
Denver, NC 28037

Phone: 704-489-1158

Contractors

Fees and Receipts:

Number	Description	Amount
	Total Fees:	**$0.00**
	Total Receipts:	**$0.00**

Conditions

Date: **Status:** **Code:**