IREDELL COUNTY HEALTH DEPARTMENT

STATESVILLE 704-878-5305 MOORESVILLE 704-664-5281

IMPROVEMENT PERMIT / AUTHORIZATION TO CONSTRUCT / OPERATION PERMIT / EXISTING SYSTEM INSPECTION

PERMIT# 102781 PIN# 4728-65 ~~0022~~ 1911 DATE 12-3-01

OWNER OR CONTRACTOR CYNTHIA D. BAILEY PHONE: Business c/o 704-902-2343 Home

ADDRESS 1128 FOURTH CREEK LANAINE STATESVILLE, NC 28625

LOCATION NC 115 NORTH, TR BAILEY FARM ROAD, 0.7 MILE ON RIGHT

SUBDIVISION BLOCK / SECTION LOT LOT AREA 14.03 ACRES SITE CLASS. PS DESIGN FLOW 360 L.T.A.R. 0.25 GPD/FT²

Septic Tank: 1000 Gallons; STB 1012 Date 12-9-01
Pump Tank: Gallons; PT Date
Pump Make: Model Serial No.
Nitrification Field: No Fields 1 Square Feet 1440 Linear Feet 480
No Lines SIX Trench Width 36" Max Trench Bottom Depth 36" Gravel Depth 12"

☑ New System ☐ Repair System Type: I (II) III, IV, V, VI
System Description: CONVENTIONAL GRAVITY
Repair System Description: CONVENTIONAL GRAVITY
Maintenance Agreement Required: ☐ Yes ☑ No


☑ House/Mod. Home No. Bedrooms 3
☐ Mobile Home No. Bathrooms 2½
☐ Business No. Employees
☐ Other
☐ Slab ☑ Crawl Space ☐ Basement w/plumbing ☐ Basement wo/plumbing

Water Supply: ☑ Individual ☐ Public ☐ Community


Comments:/Conditions: (1) SEE ATTACHED EASEMENT FOR DRAINFIELD (2) KEEP SYSTEM MINIMUM 100 FEET FROM WELL.

Comments:/Conditions: SEPTIC TANK WITH MARKER INSTALLED USING "POLYLOK" FILTER

INITIAL SITE SKETCH

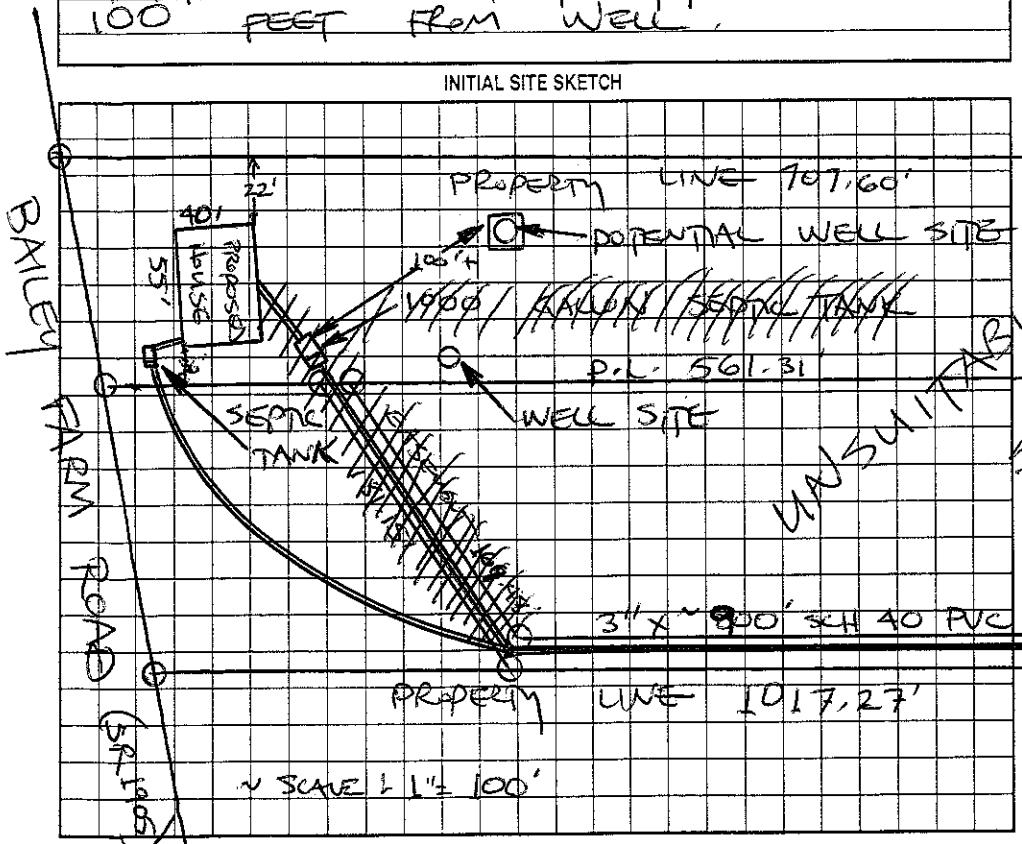

AS BUILT SKETCH

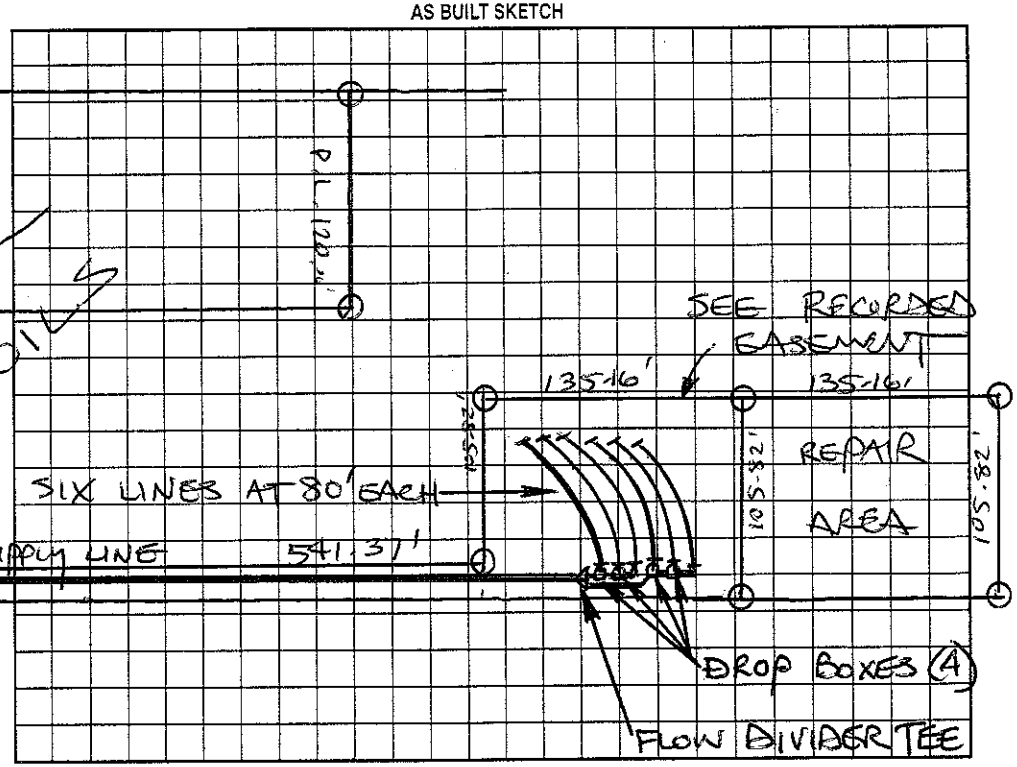

Permit can be suspended or revoked if any false information is supplied toward securing the permit/any unauthorized changes are made to the site/any unauthorized changes are made in the installation of the system. Improvement Permit with plat valid without expiration. Improvement Permit with site plan valid for sixty months. Authorization to Construct is valid for a period equal to that of Improvement Permit – not to exceed sixty months.

Signed: Ruth Wilson date 12-3-01

Improvement Permit by: STEVE HEDRICK date 12-3-01

Authorization to Construct by: STEVE HEDRICK date 12-3-01

Installed by: CRAIG THOMPSON

Operation Permit by: STEVE HEDRICK date 5-6-02

Existing System Inspection by: date

HEALTH DEPT. COPY: WHITE OWNER COPY (FINAL): YELLOW OWNER COPY (INITIAL): PINK