IREDELL COUNTY HEALTH DEPARTMENT

STATESVILLE 704-878-5305 (2) MOORESVILLE 704-664-5281

IMPROVEMENT PERMIT / AUTHORIZATION TO CONSTRUCT / OPERATION PERMIT / EXISTING SYSTEM INSPECTION

(1)

PERMIT# 145285 PIN# 4728-66-7116 DATE 10-23-07

OWNER OR APPLICANT DANIEL RUCKER PHONE: Business 828-312-3220 Home

ADDRESS 677 BAILEY FARM ROAD, STATESVILLE, NC 28625

LOCATION NC 115 NORTH, TR BAILEY FARM ROAD HOUSE ON RIGHT AT BOX # 677

SUBDIVISION BLOCK / SECTION LOT LOT AREA 0.5 ACRE SITE CLASS PS DESIGN FLOW 360 L.T.A.R. EXISTING

Septic Tank: 1000 Gallons: STB 160 Date 9-26-07
Pump Tank: Gallons: PT Date
Pump Make: Model Serial No. 100'
Nitrification Field: No Fields 1 Square Feet 900 Linear Feet EXISTING
No Lines 1 BED Trench Width 9 FT. Max Trench Bottom Depth EX. Gravel Depth 10"

☑ New System ☐ Repair ☐ Expansion System Type: I (II) III IV V VI
System Description: CONVENTIONAL, GRAVITY
Repair System Description:
Maintenance Agreement Required: ☐ Yes ☑ No

☑ House/Mod. Home ☐ Mobile Home ☐ Business ☐ Other
No. Bedrooms 3 No. Persons No. Employees


Water Supply: ☑ Individual ☐ Public ☐ Community WELL

☑ Gravity ☐ Pressure ☐ Slab ☐ Crawl Space ☑ Basement w/plumbing ☐ Basement wo/plumbing


Comments/Conditions: (1) INSTALL NEW SEPTIC TANK AT LOCATION SHOWN (2) CRUSH & FILL EXISTING SEPTIC TANK (3) SEE ATTACHED EASEMENT FOR SYSTEM LOCATION.

Comments/Conditions: (1) SEPTIC TANK W/ RISERS INSTALLED USING RED POLYLOK FILTER (2) NO ADDITIONAL BEDROOMS PERMITTED

INITIAL SITE SKETCH

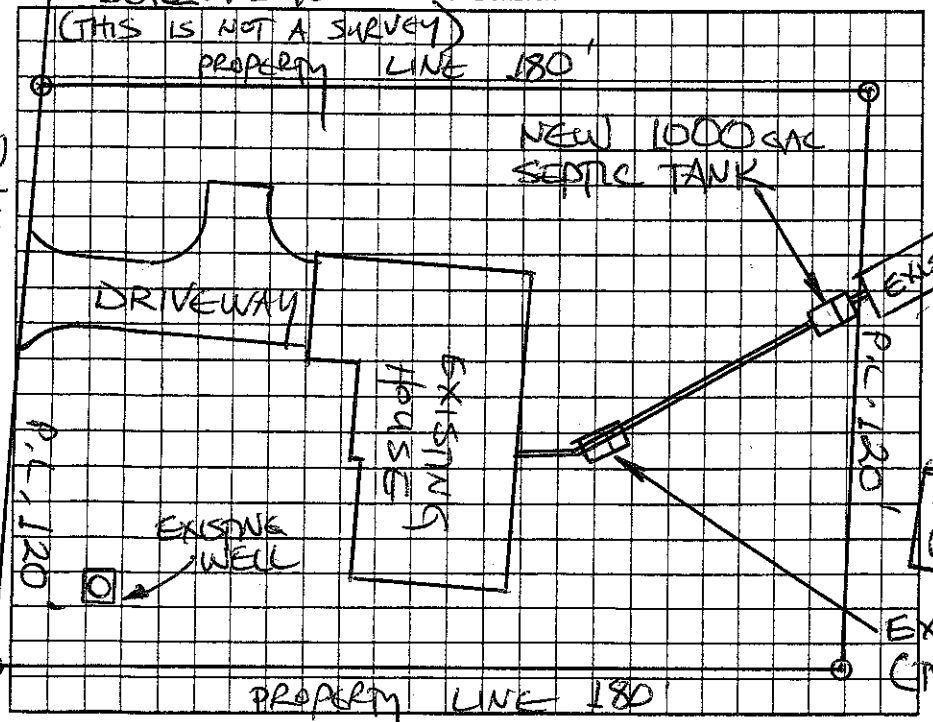

AS BUILT SKETCH

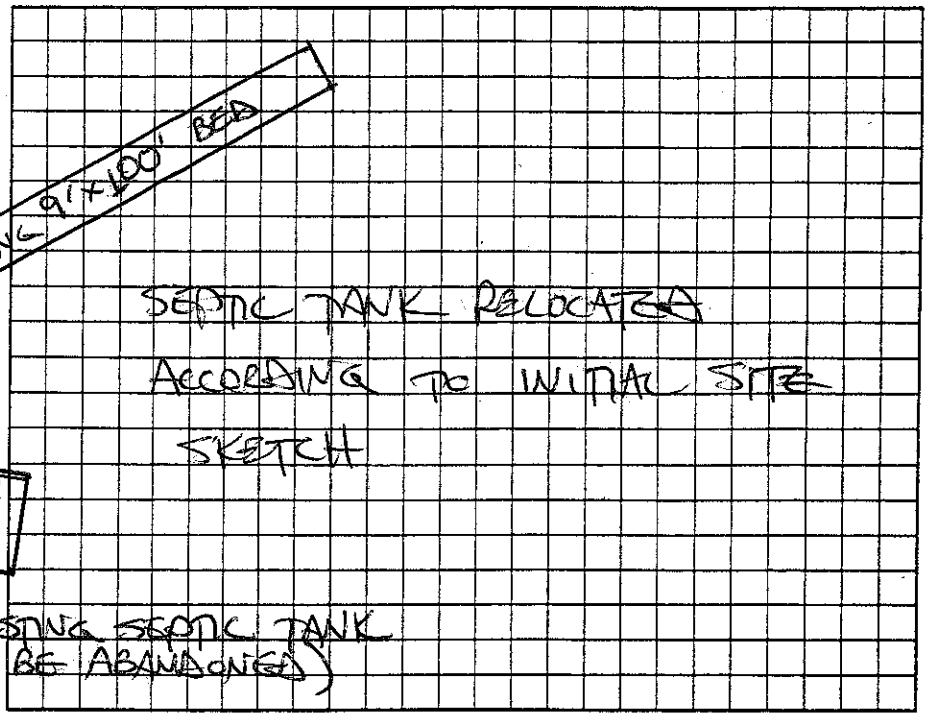

Permit can be suspended or revoked if any false information is supplied toward securing the permit/any unauthorized changes are made to the site/any unauthorized changes are made in the installation of the system. Improvement Permit with plat valid without expiration ☐ Improvement Permit with site plan valid for sixty months ☑ Authorization to Construct is valid for a period equal to that of Improvement Permit – not to exceed sixty months.

Signed: Bill Bull date 10/24/07 Installed by: SCOTT GREENE

Improvement Permit by: STEVE HEDRICK date 10-23-07 Operation Permit by: STEVE HEDRICK date 11-9-07

Authorization to Construct by: STEVE HEDRICK date 10-24-07 Existing System Inspection by: date

HEALTH DEPT. COPY: WHITE OWNER COPY (FINAL): YELLOW OWNER COPY (INITIAL): PINK