IREDELL COUNTY HEALTH DEPARTMENT

STATESVILLE 704-878-5305 MOORESVILLE 704-664-5281

IMPROVEMENT PERMIT / CERTIFICATE OF COMPLETION / OPERATION PERMIT / EXISTING SYSTEM INSPECTION

PROPERTY DESCRIPTION NO. REPAIR DATE 1-10-97 TAX MAP NO. Watershed: ☐ Yes ☒ No

OWNER OR CONTRACTOR JAMES BAILEY PHONE: Business Home 876-0036

ADDRESS 637 BAILEY FARM ROAD STATESVILLE, NC 28677

LOCATION NC 115 N, TR BAILEY FARM ROAD, 5th HOUSE ON RIGHT AT BOX #637

SUBDIVISION BLOCK / SECTION LOT LOT AREA LIMITED SITE CLASS. PS DESIGN FLOW L.T.A.R.

Septic Tank: EXISTING Gallons; STB Date

Pump Tank: Gallons; PT Date

Pump Make: Model Serial No.

Nitrification Field: No Fields 1 Square Feet 240 Linear Feet 80

No Lines 1 Trench Width 36" Max Trench Bottom Depth 36" Gravel Depth 24"

☐ New System ☑ Repair System Type: I, II, III, IV, V, VI

System Description: CONV. GRAVITY

Repair System Description: CONV. GRAVITY

Maintenance Agreement Required: ☐ Yes ☒ No

☒ House/Mod. Home No. Bedrooms 3

☐ Mobile Home No. Bathrooms 1

☐ Business No. Employees

☐ Other


☐ Slab ☑ Crawl Space ☐ Basement w/plumbing ☐ Basement wo/plumbing

Water Supply: ☒ Individual ☐ Community ☐ Public WELL

Comments: INSTALL NEW DROP BOX AS SHOWN INTO NEW 3'X80' LINE USING 24" STONE

Comments:

INITIAL SITE SKETCH

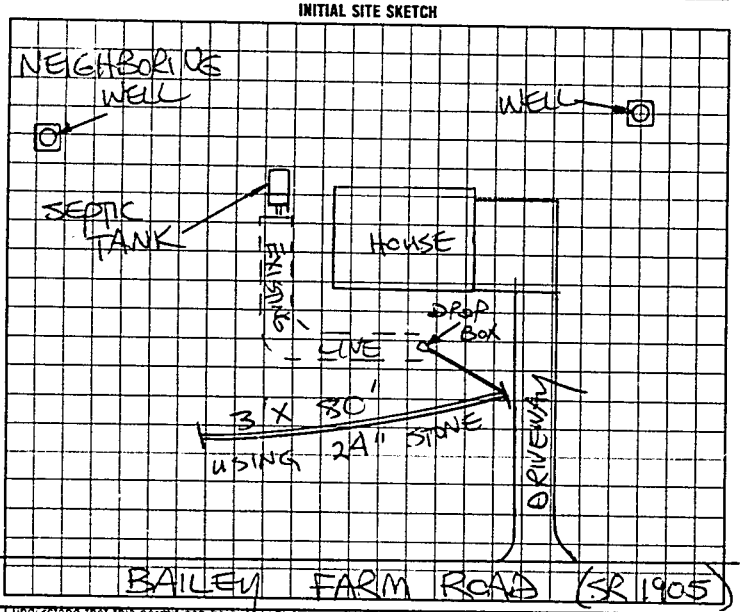

AS BUILT SKETCH

SYSTEM REPAIRED ACCORDING TO INITIAL SITE SKETCH

I understand that this permit can be suspended or revoked if any false information is supplied toward securing the permit/any unauthorized changes are made to the site/any unauthorized changes are made in the installation of the system. Improvement Permit is valid for 60 months from date of issuance. AUTH. TO CONST IS VALID FOR 60 MONTHS.

Signed: [signature]

Improvement Permit by: STEVE HEDRICK date 1-10-97

AUTH. TO CONST. Existing System Inspection by: STEVE HEDRICK date 1-10-97

Installed by: JAMES HUBLER

~~Certificate of Completion by:~~ date

Operation Permit by: STEVE HEDRICK date 1-27-97

HEALTH DEPT COPY WHITE INSPECTION COPY (FINAL) GREEN OWNER COPY (FINAL) YELLOW INSPECTION COPY (INITIAL) PINK OWNER COPY (INITIAL) GOLD