IREDELL COUNTY HEALTH DEPARTMENT

STATESVILLE 704-878-5305 MOORESVILLE 704-664-5281

IMPROVEMENT PERMIT / AUTHORIZATION TO CONSTRUCT / OPERATION PERMIT / EXISTING SYSTEM INSPECTION

PERMIT# 077837 PIN# 4738 01 4179 (PART) DATE 11-3-98

OWNER OR CONTRACTOR ERNEST RANGE PHONE: Business Home 872-6645

ADDRESS 374 LONG ISLAND ROAD, STATESVILLE NC 28677

LOCATION NC 115 N, TR BRANCHWOOD, TL RIVERFIELD, 5TH LOT ON LEFT

SUBDIVISION RIDGECREST BLOCK / SECTION II LOT 86 LOT AREA 0.551 ACRE SITE CLASS RS DESIGN FLOW 360 L.T.A.R. 0.30 GPD/FT²

Septic Tank: 1000 Gallons; STB 1012 Date 2-1-99

Pump Tank: Gallons; PT Date

Pump Make: Model Serial No

Nitrification Field: No Fields 1 Square Feet ER TO 1250 Linear Feet 300'

No Lines FOUR Trench Width 36" Max Trench Bottom Depth 36" ~~Gravel~~ Depth SAND 6"

✓ New System Repair System Type: I, II, III, IV, V, VI

System Description: 25% REDUCTION GRAVITY

Repair System Description: 25% REDUCTION GAV.

Maintenance Agreement Required: Yes ✓ No

✓ House/Mod. Home No. Bedrooms 3

✓ Mobile Home No. Bathrooms 2

Business No. Employees

Other


Slab ✓ Crawl Space Basement w/plumbing Basement wo/plumbing

Water Supply: ☐ Individual ✓ Public ☐ Community


Comments/Conditions: INSTALL 25% REDUCTION SYSTEM USING FIFTY CHAMBERS (6') OR THIRTY H.D.S. SECTIONS

Comments/Conditions:

INITIAL SITE SKETCH SCALE: 1"=40'

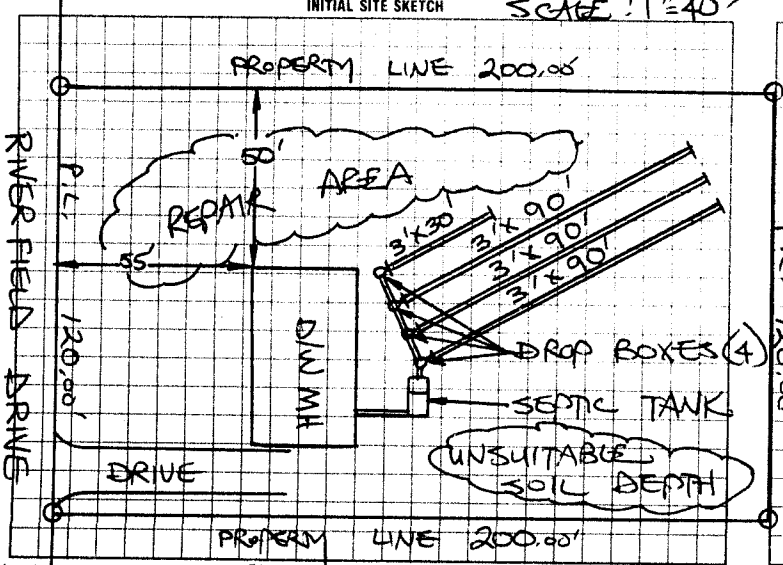

AS BUILT SKETCH

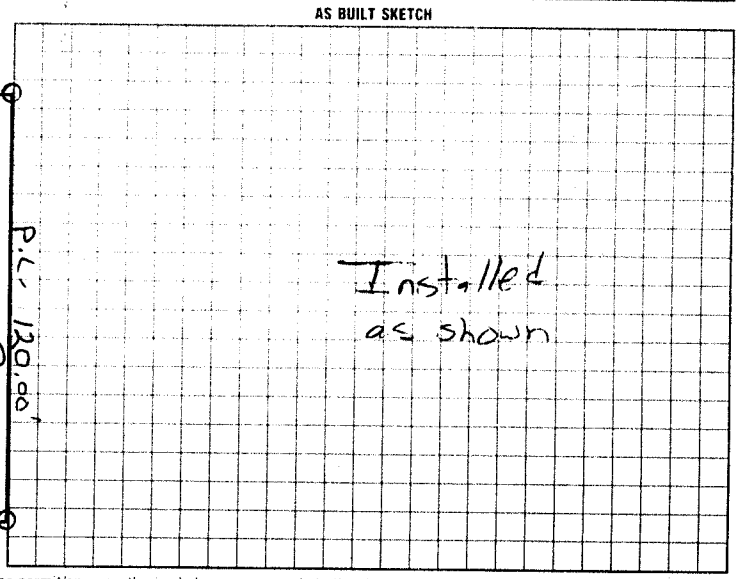

I understand that this permit can be suspended or revoked if any false information is supplied toward securing the permit/any unauthorized changes are made to the site/any unauthorized changes are made in the installation of the system. Improvement Permit with plat valid without expiration. Improvement Permit with site plan valid for sixty months. Authorization to Construct is valid for a period equal to that of Improvement Permit – not to exceed sixty months.

Signed date

Improvement Permit by: STEVE HENDRICK date 11-3-98

Authorization to Construct by: STEVE HENDRICK date 11-3-98

Installed by: A-1 Backhoe

Operation Permit by: Mary C Cuts RS date 3-26-99

Existing System Inspection by: date

HEALTH DEPT. COPY: WHITE INSPECTION COPY (FINAL): GREEN OWNER COPY (FINAL): YELLOW INSPECTION COPY (INITIAL): PINK OWNER COPY (INITIAL): GOLD