IREDELL COUNTY HEALTH DEPARTMENT

STATESVILLE 704-878-5305 MOORESVILLE 704-664-5281

IMPROVEMENT PERMIT / AUTHORIZATION TO CONSTRUCT / OPERATION PERMIT / EXISTING SYSTEM INSPECTION

PERMIT# 075733 PIN# 4738 01 4179 (PART)

OWNER OR CONTRACTOR CRAVEN & OTHERS DATE 10-1-98

ADDRESS P.O. BOX 2257, ASHEBORO, NC 27204 PHONE: Business (910) 672-2269 Home

LOCATION NC 115 N, TR BRANCHWOOD ROAD, TR RIVERFIELD DRIVE, 8TH & 9TH LOTS ON LEFT

SUBDIVISION RIDGECREST BLOCK / SECTION I LOT 89/90 LOT AREA 1.102 ACRES SITE CLASS PS+ DESIGN FLOW 360 L.T.A.R. 0.30 GPD/FT²

Septic Tank: 1000 Gallons; STB 1012 Date 8-2-98

Pump Tank: _____ Gallons; PT _____ Date _____

Pump Make: _____ Model _____ Serial No. _____

Nitrification Field: No Fields 1 Square Feet 60 to 1200 Linear Feet 300+

No Lines FOUR Trench Width 36" Max Trench Bottom Depth 24" Gravel Depth SAND 6"

☑ New System ☐ Repair System Type: I, II, III, IV, V, VI

System Description: CHAMBERED GRAVITY

Repair System Description: CHAMBERED GRAVITY

Maintenance Agreement Required: ☐ Yes ☑ No

☐ House/Mod. Home ☑ Mobile Home ☐ Business ☐ Other

No. Bedrooms 3 No. Bathrooms 2 No. Employees ____


☐ Slab ☑ Crawl Space ☐ Basement w/plumbing ☐ Basement wo/plumbing

Water Supply: ☐ Individual ☑ Public ☐ Community

Comments:/Conditions: INSTALL FIFTY CHAMBERS ON CONTOUR AS FLAGGED (OWNER'S REQUEST)

Comments:/Conditions:

INITIAL SITE SKETCH

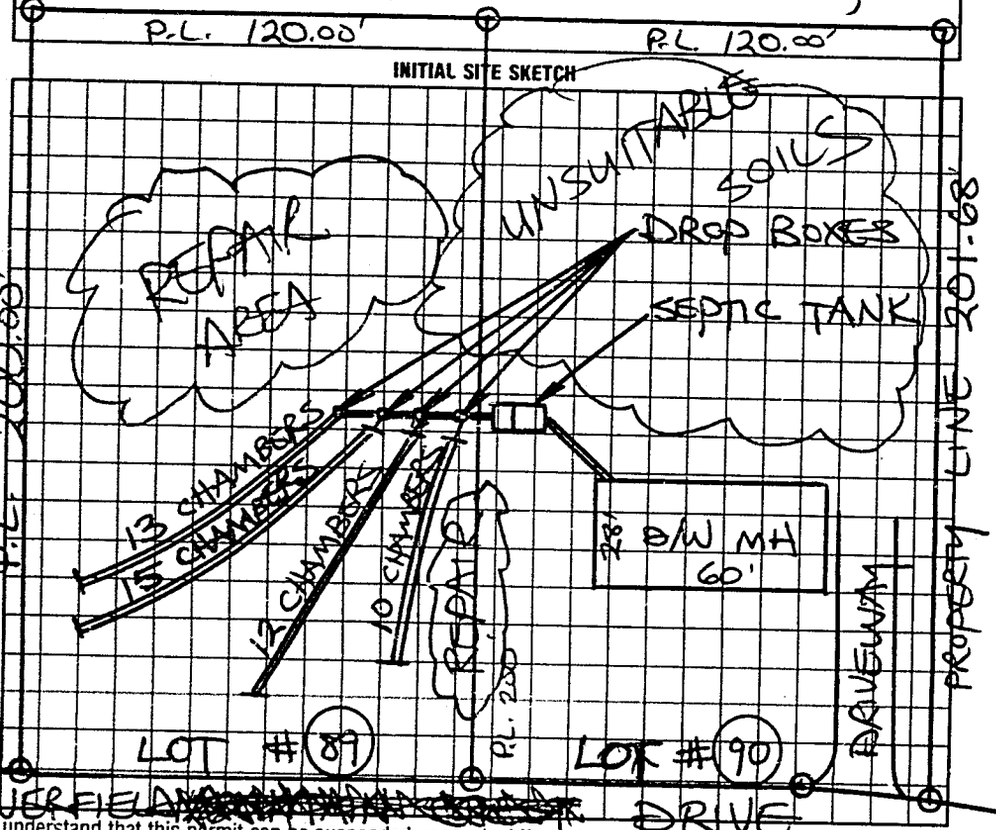

AS BUILT SKETCH

SYSTEM INSTALLED ACCORDING TO INITIAL SITE SKETCH

I understand that this permit can be suspended or revoked if any false information is supplied toward securing the permit/any unauthorized changes are made to the site/any unauthorized changes are made in the installation of the system. Improvement Permit with plat valid without expiration. Improvement Permit with site plan valid for sixty months. Authorization to Construct is valid for a period equal to that of Improvement Permit – not to exceed sixty months.

Signed: _____ date 10/01/98

Improvement Permit by: STEVE HEDRICK date 10-1-98

Authorization to Construct by: STEVE HEDRICK date 10-1-98

Installed by: A-1 BACKHOE

Operation Permit by: STEVE HEDRICK date 10-1-98

Existing System Inspection by: _____ date _____

HEALTH DEPT. COPY: WHITE INSPECTION COPY (FINAL): GREEN OWNER COPY (FINAL): YELLOW INSPECTION COPY (INITIAL): PINK OWNER COPY (INITIAL): GOLD