IREDELL COUNTY HEALTH DEPARTMENT

STATESVILLE 704-878-5305 MOORESVILLE 704-664-5281

IMPROVEMENT PERMIT / AUTHORIZATION TO CONSTRUCT / OPERATION PERMIT / EXISTING SYSTEM INSPECTION

PERMIT # 16175 PIN # 4728-80-8134 DATE 5-20-10

OWNER or APPLICANT (Clayton Homes) Peggy Connelley PHONE: Business 704 873 2597 Home:

~~OWNER or APPLICANT~~ SITE ADDRESS 2026 Northside Drive

LOCATION / DIRECTIONS 126 Riverfield

SUBDIVISION Ridgecrest BLOCK / SECTION LOT # 57 LOT AREA n/a DESIGN FLOW EX L.T.A.R. EX

Septic Tank	EX	Gallons: STB	EX	Date	EX	☐ New System	☐ Repair	☐ Expansion System	Type I (II) III IV V VI	☒ Residence	No. Bedrooms 3
Pump Tank		Gallons: P T		Date		System Description: Conventional Gravity				☐ Business	No. Persons
Pump Make		Model		Serial #		Repair System Description: Conventional Gravity				☐ Other	No. Employees
Nitrification Field	No Fields EX	No Lines EX	Linear Feet EX			Maintenance Agreement Required	☐ YES	☒ NO		☐ Slab	☒ Crawl Space
Trench Width	EX	Max. Trench Bottom Depth	EX	Gravel Depth	EX	☒ GRAVITY	☐ PRESSURE			☐ Basement w/plumbing	☐ Basement w/o plumbing


Water Supply: ☐ Private ☒ Public ☐ Community

Comments / Conditions

Comments / Conditions

INITIAL SITE SKETCH

AS BUILT SKETCH

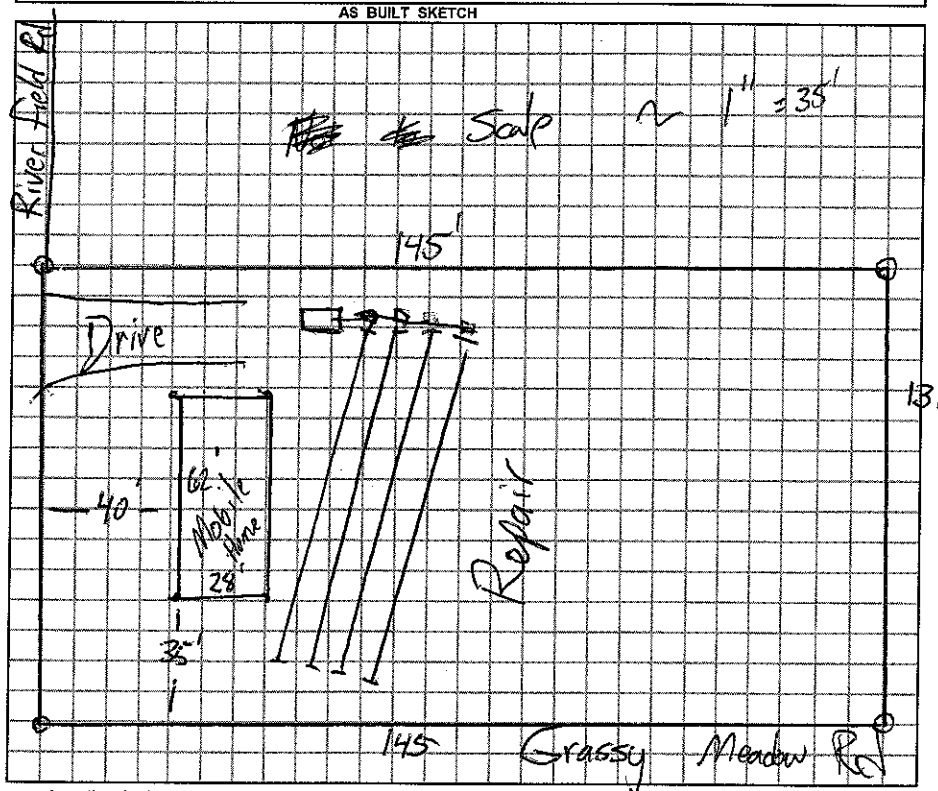

Permit can be suspended or revoked if any false information is supplied toward securing the permit / any unauthorized changes are made to the site / any unauthorized changes are made in the installation of the system.

☐ *IMPROVEMENT PERMIT w / plat valid without expiration.* ☐ *IMPROVEMENT PERMIT w / site plan valid for 60 mos.* ☐ *AUTHORIZATION TO CONSTRUCT valid for period equal to IMPROVEMENT PERMIT-not to exceed 60 mo.*

Owner / Applicant Signature: Date 5-24-10

Improvement Permit by: Date

Authorzation to Construct by: Date

YOU SHOULD CONTACT A LOCATOR SERVICE PRIOR TO ANY EXCAVATION.

Installed by:

Operation Permit by: Date:

Existing System Inspected by: Date: 5-20-10

WHITE COPY Environmental Health YELLOW COPY (Final) Owner / Applicant PINK COPY (Initial) Owner / Applicant