IREDELL COUNTY HEALTH DEPARTMENT

STATESVILLE 704-878-5305 MOORESVILLE 704-664-5281

IMPROVEMENT PERMIT / AUTHORIZATION TO CONSTRUCT / OPERATION PERMIT / EXISTING SYSTEM INSPECTION

PERMIT# 079066 PIN# 4728 80 8257 DATE 2-4-99

OWNER OR CONTRACTOR ERNEST RUNSE PHONE: Business 881-7273 Home

ADDRESS 374 LONG ISLAND ROAD, STATESVILLE NC 28677

LOCATION NC 115 N TR BRANCHWOOD ROAD, TL RIVERFIELD DRIVE, 2ND LOT ON RIGHT

SUBDIVISION RIDGECREST 1 BLOCK / SECTION II LOT 120 LOT AREA 0.73 ACRE SITE CLASS PS DESIGN FLOW 360 L.T.A.R. 0.30 gpd/ft²

Septic Tank: 1000 Gallons; STB Date

Pump Tank: Gallons; PT Date

Pump Make: Model Serial No

Nitrification Field: No. Fields 1 Square Feet 1200 Linear Feet 400

No. Lines FOUR Trench Width 36" Max Trench Bottom Depth 36" Gravel Depth 12"

☑ New System ☐ Repair System Type: ☐ II ☐ III ☐ IV ☐ V ☐ VI

System Description: CONVENTIONAL GRAVITY

Repair System Description: CONV. GRAVITY

Maintenance Agreement Required: Yes No ☑

☐ House/Mod. Home ☐ Mobile Home ☐ Business ☐ Other

No. Bedrooms 3 No. Bathrooms 2 No. Employees

☐ Slab ☑ Crawl Space ☐ Basement w/plumbing ☐ Basement wo/plumbing

Water Supply: ☐ Individual ☑ Public ☐ Community


Comments/Conditions:

Comments/Conditions:


2

SCALE: 1" = 40'

INITIAL SITE SKETCH

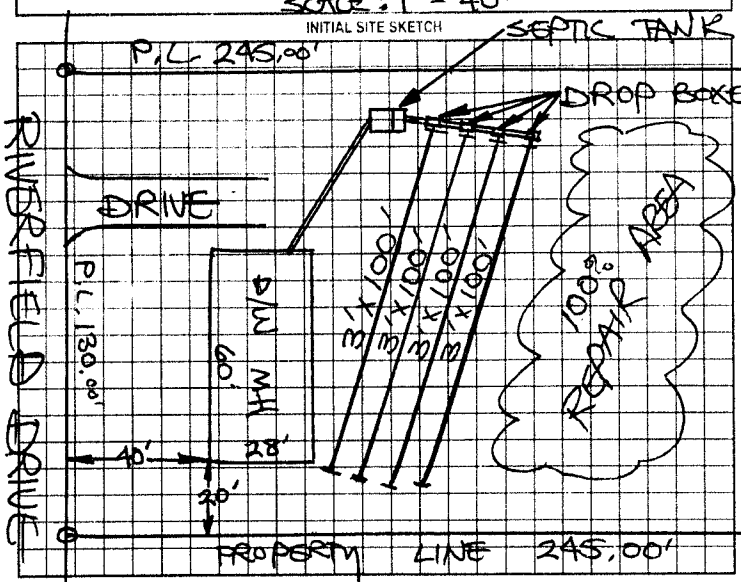

AS BUILT SKETCH

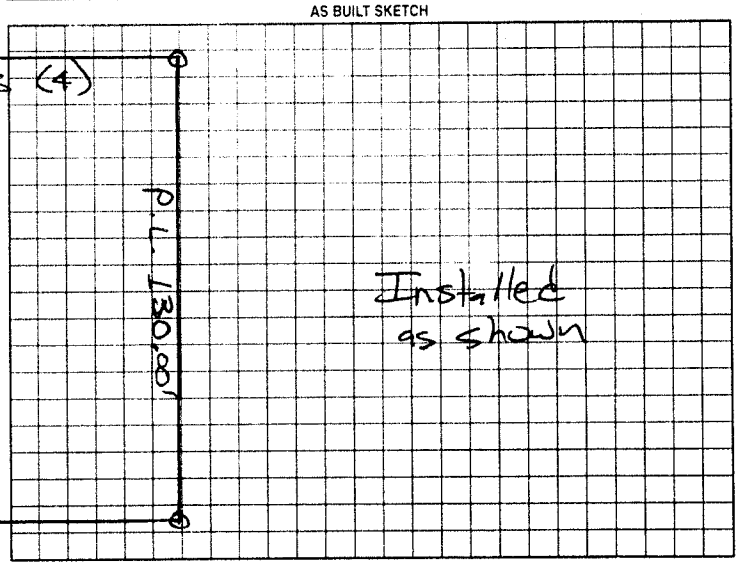

Permit can be suspended or revoked if any false information is supplied toward securing the permit/any unauthorized changes are made to the site/any unauthorized changes are made in the installation of the system. Improvement Permit with plat valid without expiration. Improvement Permit with site plan valid for sixty months. Authorization to Construct is valid for a period equal to that of Improvement Permit -- not to exceed sixty months.

Signed: date 2-4-99

Improvement Permit by: STEVE HEDRICK date 2-4-99

Authorization to Construct by: STEVE HEDRICK date 2-4-99

Installed by: A-1 Backhoe

Operation Permit by: Mary C Owens date 5-11-99

Existing System Inspection by: date

HEALTH DEPT COPY WHITE OWNER COPY (FINAL) YELLOW OWNER COPY (INITIAL) PINK