IREDELL COUNTY HEALTH DEPARTMENT

STATESVILLE 704-878-5305 MOORESVILLE 704-664-5281

IMPROVEMENT PERMIT / AUTHORIZATION TO CONSTRUCT / OPERATION PERMIT / EXISTING SYSTEM INSPECTION

PERMIT# 079474 PIN# 4728 80 8379 DATE 3-12-99

OWNER OR CONTRACTOR CRAVEN, ET AL PHONE: Business 872-6695 Home

ADDRESS P.O. Box 2257, ASHEBORO, NC 27204

LOCATION NC 115 N, TR BRANCHWOOD TL RIVERFIELD DRIVE, 5TH LOT ON RIGHT

SUBDIVISION RIDGECREST BLOCK / SECTION II LOT 1191 LOT AREA 0.731 ACRES SITE CLASS PS DESIGN FLOW 360 L.T.A.R. 0.30 GPD/FT²

Septic Tank: 1000 Gallons; STB 1012 Date 3-22-99
Pump Tank: Gallons; PT Date
Pump Make: Model Serial No.
Nitrification Field: No Fields 1 Square Feet EQ. TO 1440 Linear Feet 3604
No Lines FOUR Trench Width 36" Max Trench Bottom Depth 30" Gravel Depth 12"

☑ New System ☐ Repair System Type: I. II (III.) IV. V. VI
System Description: 25% REDUCTION GRAVITY
Repair System Description: 25% REDUCTION GRAVITY
Maintenance Agreement Required: ☐ Yes ☑ No

☑ House/Mod. Home No. Bedrooms 3
☐ Mobile Home No. Bathrooms 2
☐ Business No. Employees
☐ Other


☐ Slab ☑ Crawl Space ☐ Basement w/plumbing ☐ Basement wo/plumbing

Water Supply: ☐ Individual ☑ Public ☐ Community


Comments/Conditions: ① INSTALL 25% REDUCTION SYSTEM USING FIFTY (50) CHAMBERS OR THIRTY-SIX (36) H.D.S. SECTIONS ② CONSTRUCT SUBSURFACE INTERCEPT DITCH BEGINNING 42" DEEP OUT TO DAYLIGHT

Comments/Conditions

INITIAL SITE SKETCH

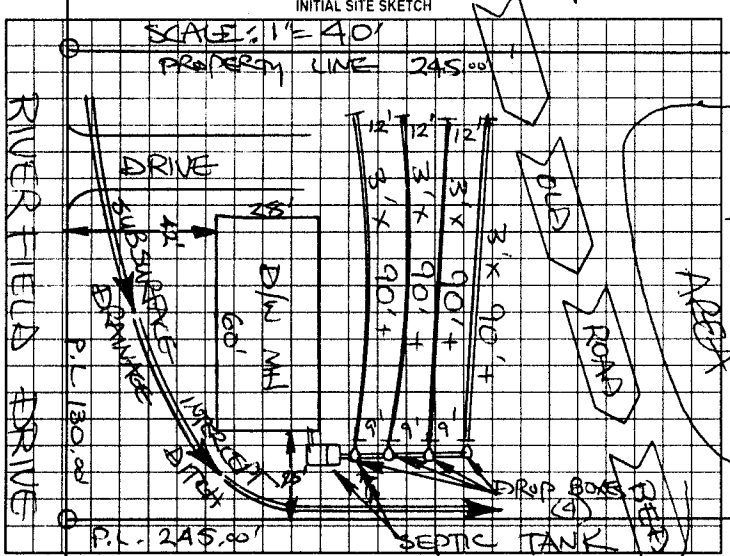

AS BUILT SKETCH

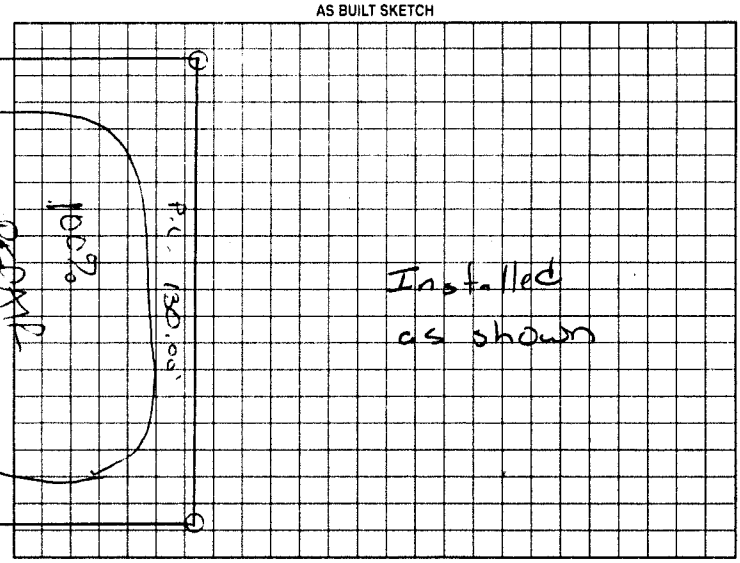

Permit can be suspended or revoked if any false information is supplied toward securing the permit/any unauthorized changes are made to the site/any unauthorized changes are made in the installation of the system. Improvement Permit with plat valid without expiration. Improvement Permit with site plan valid for sixty months. Authorization to Construct is valid for a period equal to that of Improvement Permit - not to exceed sixty months.

Signed: [signature] date 3-17-99 Installed by: A-1 Backhoe

Improvement Permit by: STEVE HENDRICK date 3-12-99 Operation Permit by: [signature] date 5-11-99

Authorization to Construct by: STEVE HENDRICK date 3-12-99 Existing System Inspection by: date

HEALTH DEPT COPY WHITE OWNER COPY (FINAL) YELLOW OWNER COPY (INITIAL) PINK