pd 125 8-31-98

IREDELL COUNTY HEALTH DEPARTMENT

STATESVILLE 704-878-5305 MOORESVILLE 704-664-5281

IMPROVEMENT PERMIT / AUTHORIZATION TO CONSTRUCT / OPERATION PERMIT / EXISTING SYSTEM INSPECTION

PERMIT# 075734 PIN# 4738 01 4179 (PART) DATE 8-29-98

OWNER OR CONTRACTOR CRAVEN & OTHERS PHONE: Business (910) 672-2269 Home 872-6645

ADDRESS P.O. BOX 2257, ASHEBORO NC 27204

LOCATION NC 115 N, TR BRANCHWOOD, TL RIVERFIELD, TR MTN. CREST, 1ST LOT ON LEFT

SUBDIVISION RIDGECREST BLOCK / SECTION II LOT 101 LOT AREA 0.834 ACRE SITE CLASS. PS DESIGN FLOW 360 L.T.A.R. 0.30 GPD/FT²

Septic Tank: 1000 Gallons; STB 1012 Date 1-6-98
Pump Tank: _____ Gallons; PT _____ Date _____
Pump Make: _____ Model _____ Serial No. _____
Nitrification Field: No Fields 1 Square Feet EQ.P01200 Linear Feet 300'+
No Lines FIVE Trench Width 36" Max Trench Bottom Depth 36" ~~Gravel~~ Depth SAND 6"

☑ New System ☐ Repair System Type: I, II, III, IV, V, VI
System Description: 25% REDUCTION GRAVITY
Repair System Description: LPP
Maintenance Agreement Required: ☐ Yes ☑ No


☐ House/Mod. Home ☑ Mobile Home ☐ Business ☐ Other
No. Bedrooms 3 No. Bathrooms 2 No. Employees _____
☐ Slab ☑ Crawl Space ☐ Basement w/plumbing ☐ Basement wo/plumbing

Water Supply: ☐ Individual ☑ Public ☐ Community

Comments/Conditions: SEE ATTACHED PLAT & EASEMENT FOR SEWAGE DISPOSAL

Comments/Conditions:

INITIAL SITE SKETCH SCALE: 1"=50'

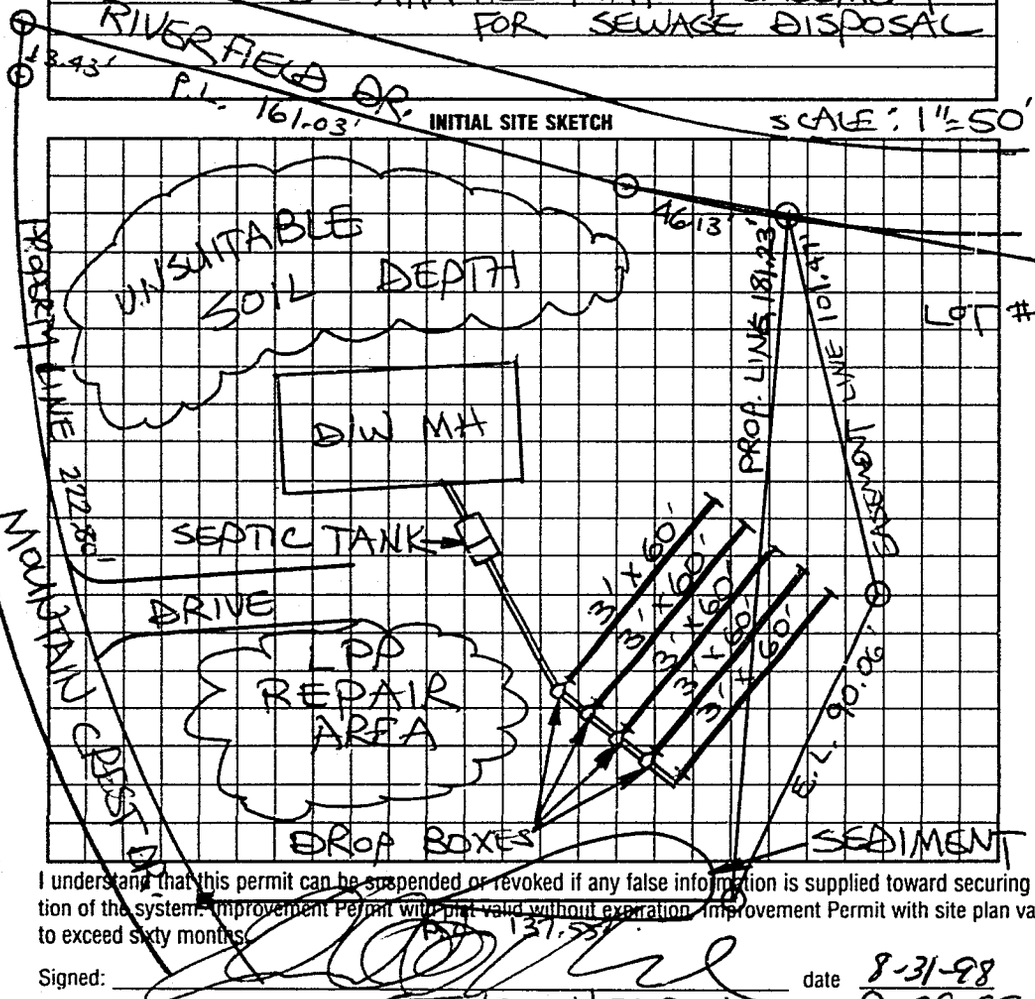

AS BUILT SKETCH

I understand that this permit can be suspended or revoked if any false information is supplied toward securing the permit/any unauthorized changes are made to the site/any unauthorized changes are made in the installation of the system. Improvement Permit with plat valid without expiration. Improvement Permit with site plan valid for sixty months. Authorization to Construct is valid for a period equal to that of Improvement Permit – not to exceed sixty months.

Signed: _____ date 8-31-98 Installed by: A-1 BACKHOE

Improvement Permit by: STEVE HEDRICK date 8-29-98 Operation Permit by: STEVE HEDRICK date 10-12-98

Authorization to Construct by: STEVE HEDRICK date 10-12-98 Existing System Inspection by: _____ date _____

HEALTH DEPT. COPY: WHITE INSPECTION COPY (FINAL): GREEN OWNER COPY (FINAL): YELLOW INSPECTION COPY (INITIAL): PINK OWNER COPY (INITIAL): GOLD

92800