IREDELL COUNTY HEALTH DEPARTMENT

THIS PERMIT VOIDS PREVIOUS ISSUED 10/4/04

STATESVILLE 704-878-5305 (C1) MOORESVILLE 704-664-5281

IMPROVEMENT PERMIT / AUTHORIZATION TO CONSTRUCT / OPERATION PERMIT / EXISTING SYSTEM INSPECTION

PERMIT# 122072 PIN# 4728-81-5088 DATE 3-22-05

OWNER OR CONTRACTOR CRAVEN, KEARNS, ET AL PHONE: Business (704) 902-0962 Home (704) 873-2547

ADDRESS P.O. BOX 2257, ASHEBORO NC 27204

LOCATION NC 115 N, TR BRANCHWOOD, TL RIVERFIELD, LOTS ON LEFT NEAR END,

SUBDIVISION RIDGECREST BLOCK / SECTION II LOT 93/94 LOT AREA 3.942 ACRES SITE CLASS. PS DESIGN FLOW 360 L.T.A.R. 0.30 GPD/FT²

Septic Tank: 1000 Gallons; STB 1012 Date 1-4-05
Pump Tank: ____ Gallons; PT ____ Date ____
Pump Make: ____ Model ____ Serial No. ____
Nitrification Field: No Fields 1 Square Feet 360/1200 Linear Feet 300
No Lines FOUR Trench Width 36" Max Trench Bottom Depth 30" Gravel Depth N/A

☑ New System ☐ Repair System Type: I, II, III, IV, V, VI
System Description: 25% REDUCTION, GRAVITY
Repair System Description: CONVENTIONAL, PUMP
Maintenance Agreement Required: ☐ Yes ☑ No


☐ House/Mod. Home ☑ Mobile Home ☐ Business ☐ Other
No. Bedrooms 3 No. Bathrooms ____ No. Employees ____
☐ Slab ☑ Crawl Space ☐ Basement w/plumbing ☐ Basement wo/plumbing

Water Supply: ☐ Individual ☑ Public ☐ Community

Comments:/Conditions: ① INSTALL 25% REDUCTION SYSTEM ON CONTOUR AS SHOWN ② NO VEHICULAR TRAFFIC ALLOWED OVER SYSTEM, ③ INSTALL LINES NO DEEPER THAN 30".

Comments:/Conditions: SEPTIC TANK WITH MARKER INSTALLED USING "TUFTITE" FILLER

INITIAL SITE SKETCH

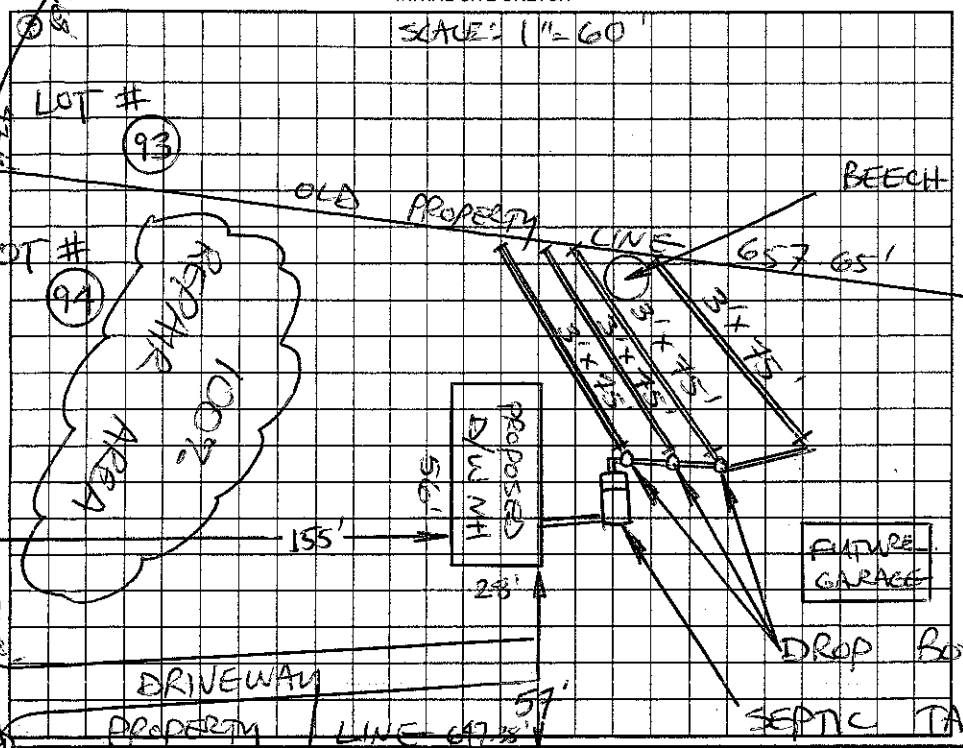

AS BUILT SKETCH

SYSTEM INSTALLED ACCORDING TO INITIAL SITE SKETCH

Permit can be suspended or revoked if any false information is supplied toward securing the permit/any unauthorized changes are made to the site/any unauthorized changes are made in the installation of the system. Improvement Permit with plat valid without expiration. Improvement Permit with site plan valid for sixty months. Authorization to Construct is valid for a period equal to that of Improvement Permit – not to exceed sixty months.

Signed: [signature] date 3/24/05 Installed by: A-1 BACKHOE

Improvement Permit by: STEVE HEDRICK date 3-22-05 Operation Permit by: STEVE HEDRICK date 4-5-05

Authorization to Construct by: STEVE HEDRICK date 3-24-05 Existing System Inspection by: ____ date ____

HEALTH DEPT. COPY: WHITE OWNER COPY (FINAL): YELLOW OWNER COPY (INITIAL): PINK