IREDELL COUNTY HEALTH DEPARTMENT

STATESVILLE 704-878-5305 MOORESVILLE 704-664-5281

IMPROVEMENT PERMIT / AUTHORIZATION TO CONSTRUCT / OPERATION PERMIT / EXISTING SYSTEM INSPECTION

PERMIT# 088768 PIN# 4728 85 5499 DATE 5-8-00

OWNER OR CONTRACTOR KEITH BENFIELD PHONE: Business Home 876-4713

ADDRESS 154 SNOW CREEK ROAD, STATESVILLE NC 28625

LOCATION NC 115 NORTH, TR BAILEY FARM RD, TR BENFIELD FARM RD, 1ST LOT ON LEFT

SUBDIVISION BLOCK / SECTION LOT LOT AREA 146.48 ACRES SITE CLASS PS DESIGN FLOW 240 L.T.A.R. 0.25 GPD/FT²

Septic Tank: 1000 Gallons; STB 620 Date 3-7-00
Pump Tank: Gallons; PT Date
Pump Make: Model Serial No.
Nitrification Field: No Fields 1 Square Feet 960 Linear Feet 320
No Lines FOUR Trench Width 36" Max Trench Bottom Depth 30" Gravel Depth 12"

☑ New System ☐ Repair System Type: I (II) III IV V VI
System Description: CONVENTIONAL GRAVITY
Repair System Description: CONVENTIONAL PUMP
Maintenance Agreement Required: ☐ Yes ☑ No
☐ Slab ☑ Crawl Space ☐ Basement w/plumbing ☐ Basement wo/plumbing


☐ House/Mod. Home No. Bedrooms 2
☑ Mobile Home No. Bathrooms 1
☐ Business No Employees
☐ Other

Water Supply: ☑ Individual ☐ Public ☐ Community
WELL NEXT DOOR

Comments/Conditions: INSTALL SUBSURFACE INTERCEPT DRAINAGE DITCH AS SHOWN BEGINNING 42" DEEP OUT TO DAYLIGHT

Comments/Conditions: SEPTIC TANK W/ RISERS INSTALLED USING "TUFTITE" FILTER

INITIAL SITE SKETCH

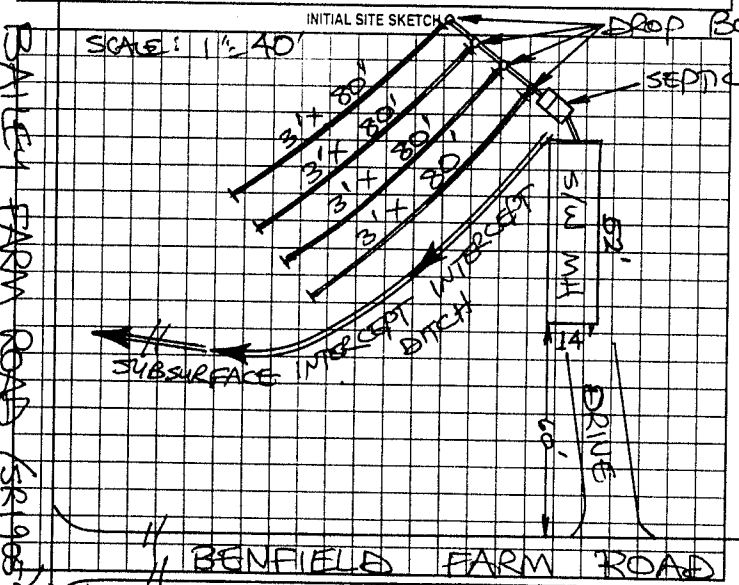

AS BUILT SKETCH

SYSTEM INSTALLED ACCORDING TO INITAL SITE SKETCH

Permit can be suspended or revoked if any false information is supplied toward securing the permit/any unauthorized changes are made to the site/any unauthorized changes are made in the installation of the system. Improvement Permit with plat valid without expiration. Improvement Permit with site plan valid for sixty months. Authorization to Construct is valid for a period equal to that of Improvement Permit – not to exceed sixty months.

Signed: [signature] date 5-8-00 Installed by: SAMMY REVIS

Improvement Permit by: STEVE HEDRICK date 5-8-00 Operation Permit by: STEVE HEDRICK date 5-24-00

Authorization to Construct by: STEVE HEDRICK date 5-8-00 Existing System Inspection by: date

HEALTH DEPT. COPY: WHITE OWNER COPY (FINAL): YELLOW OWNER COPY (INITIAL): PINK