IREDELL COUNTY HEALTH DEPARTMENT

THIS PERMIT VOIDS PREVIOUS ISSUED 7-14-99

STATESVILLE 704-878-5305 MOORESVILLE 704-664-5281

IMPROVEMENT PERMIT / AUTHORIZATION TO CONSTRUCT / OPERATION PERMIT / EXISTING SYSTEM INSPECTION

PERMIT# 081504 PIN# 4728 90 4640 DATE 12-29-99

OWNER OR CONTRACTOR ERNEST RUNGE PHONE: Business 872-6695 Home

ADDRESS 374 LONG ISLAND RD, STATESVILLE, NC 28677

LOCATION NC115 N, TR BRANCHWOOD, TL RIVERFIELD, TR MOUNTAIN CREST, 4th LOT ON RIGHT

SUBDIVISION RIDGECREST BLOCK / SECTION II LOT 114 LOT AREA 1.920 ACRES SITE CLASS PS DESIGN FLOW 480 L.T.A.R. 0.30 GPD/FT²

Septic Tank: 1000 Gallons: STB 1012 Date 10-28-99

Pump Tank: Gallons: PT Date

Pump Make: Model Serial No.

Nitrification Field: No Fields 1 Square Feet EQ. TO 1600 Linear Feet 400 ±

No Lines FOUR Trench Width 36" Max Trench Bottom Depth (32")

☑ New System ☐ Repair System Type: I, II, III, IV, V, VI

System Description: 25% REDUCTION GRAVITY

Repair System Description: 25% REDUCTION GRAVITY

Maintenance Agreement Required: ☐ Yes ☑ No

Gravel Depth 12" ☐ Slab ☑ Crawl Space ☐ Basement w/plumbing ☐ Basement wo/plumbing

☐ House/Mod. Home ☑ Mobile Home ☐ Business ☐ Other


No. Bedrooms 4 No. Bathrooms 2 No. Employees

Water Supply: ☐ Individual ☑ Public ☐ Community


Comments/Conditions: INSTALL 25% REDUCTION SYSTEM USING SIXTY-SEVEN (67) CHAMBERS OR FORTY (40) HDS SECTIONS ON CONTOUR AS FLAGGED

Comments/Conditions: SYSTEM SIZED FOR FOUR BEDROOM SEPTIC TANK W/ RISER INSTALLED USING "POLYLOK" FILTER

INITIAL SITE SKETCH

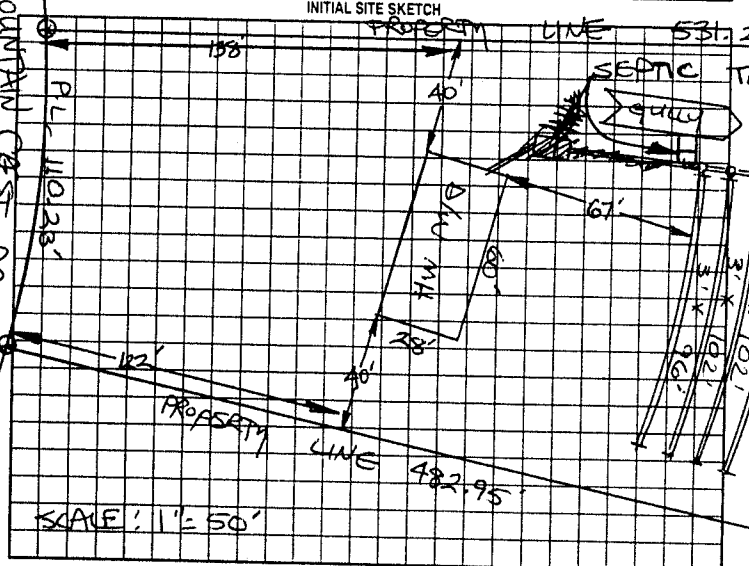

AS BUILT SKETCH

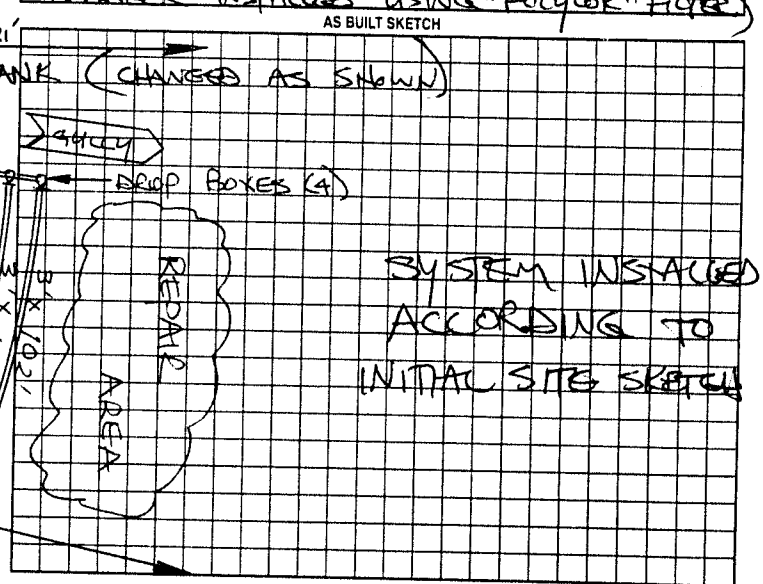

Permit can be suspended or revoked if any false information is supplied toward securing the permit/any unauthorized changes are made to the site/any unauthorized changes are made in the installation of the system. Improvement Permit with plat valid without expiration. Improvement Permit with site plan valid for sixty months. Authorization to Construct is valid for a period equal to that of Improvement Permit – not to exceed sixty months.

Signed: [signature] date 30 DAY PS

Improvement Permit by: STEVE HEDRICK date 12-29-99

Authorization to Construct by: STEVE HEDRICK date 12-29-99

Installed by: A-1 BACKHOE

Operation Permit by: STEVE HEDRICK date 1-6-00

Existing System Inspection by: date

HEALTH DEPT. COPY: WHITE OWNER COPY (FINAL): YELLOW OWNER COPY (INITIAL): PINK