IREDELL COUNTY HEALTH DEPARTMENT

STATESVILLE 704-878-5305 MOORESVILLE 704-664-5281

IMPROVEMENT PERMIT / AUTHORIZATION TO CONSTRUCT / OPERATION PERMIT / EXISTING SYSTEM INSPECTION

PERMIT# 0986898 PIN# 4738 00 3365 (PT) DATE 12-29-99

OWNER OR CONTRACTOR CRAVEN & OTHERS PHONE: Business 872-6645 Home

ADDRESS 374 LONG ISLAND ROAD, STATESVILLE, NC 28677

LOCATION NC 115 N, TR BRANCHWOOD, TL RIVERFIELD, TR GRASSY MEADOW LANE, 8TH LOT ON LEFT

SUBDIVISION RIVERCREST BLOCK / SECTION III LOT 50 LOT AREA 1.29 ACRES SITE CLASS PS DESIGN FLOW 360 L.T.A.R. 0.33 GPD/FT²

Septic Tank: 1000 Gallons: STB 1012 Date 10-28-99
Pump Tank: Gallons: PT Date
Pump Make: Model Serial No.
Nitrification Field: No Fields 1 Square Feet 1080 Linear Feet 360
No Lines SIX Trench Width 36" Max Trench Bottom Depth 30" Gravel Depth 12"

☑ New System ☐ Repair System Type: I (II) III, IV, V, VI
System Description: CONVENTIONAL GRAVITY
Repair System Description: LPP OR LDP
Maintenance Agreement Required: ☐ Yes ☑ No
☐ Slab ☑ Crawl Space ☐ Basement w/plumbing ☐ Basement wo/plumbing


☐ House/Mod. Home No. Bedrooms 3
☑ Mobile Home No. Bathrooms 2
☐ Business No. Employees
☐ Other

Water Supply: ☐ Individual ☑ Public ☐ Community


Comments/Conditions: ① INSTALL LINES ON CONTOUR, NO DEEPER THAN 30" ② USE ONE FLOW DIVIDER TEE TO ACHIEVE EQUAL DISTRIBUTION INTO TWO SETS OF DROP BOXES FEEDING 3 LINES

Comments/Conditions: SEPTIC TANK W/ MARKER INSTALLED USING "POLYLOK" FILTER

SCALE: 1" = 50' INITIAL SITE SKETCH

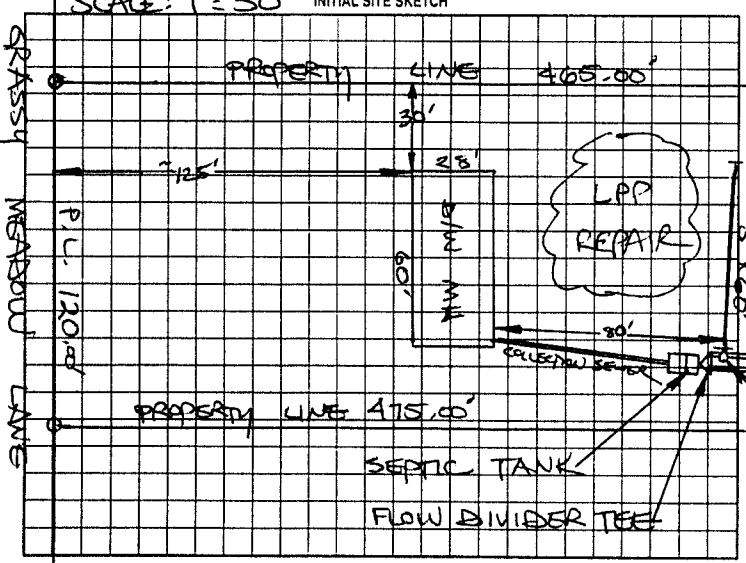

AS BUILT SKETCH

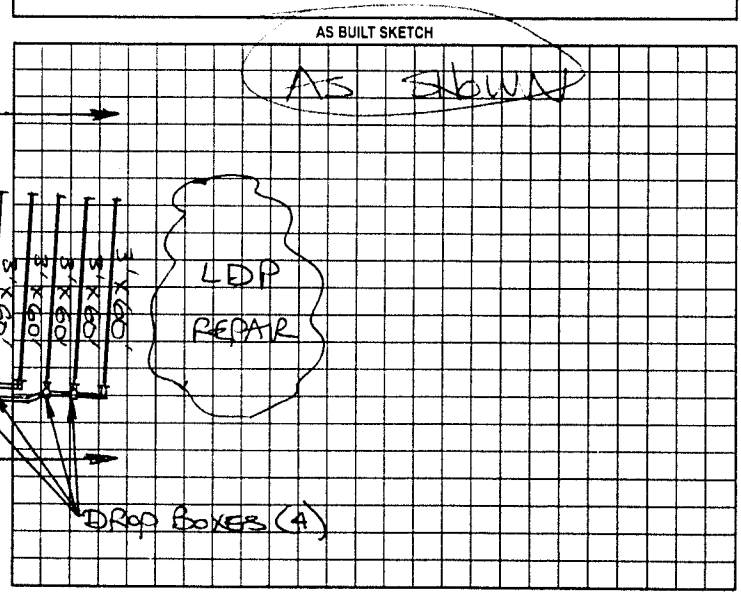

Permit can be suspended or revoked if any false information is supplied toward securing the permit/any unauthorized changes are made to the site/any unauthorized changes are made in the installation of the system. Improvement Permit with plat valid without expiration. Improvement Permit with site plan valid for sixty months. Authorization to Construct is valid for a period equal to that of Improvement Permit – not to exceed sixty months.

Signed: [signature] date 30 Dec 99 Installed by: A-1 BACKHOE

Improvement Permit by: STEVE HEDRICK date 12-29-99 Operation Permit by: STEVE HEDRICK date 1-6-99

Authorization to Construct by: STEVE HEDRICK date 12-29-99 Existing System Inspection by: date

HEALTH DEPT COPY WHITE OWNER COPY (FINAL) YELLOW OWNER COPY (INITIAL) PINK