IREDELL COUNTY HEALTH DEPARTMENT

STATESVILLE 704-878-5305 MOORESVILLE 704-664-5281

IMPROVEMENT PERMIT / AUTHORIZATION TO CONSTRUCT / OPERATION PERMIT / EXISTING SYSTEM INSPECTION

PERMIT# ~~2005065~~ 120084 PIN# ~~4728 96 6968~~ 4728910174 DATE 8/31/04

OWNER OR CONTRACTOR PHIL CRAVEN PHONE: Business 336-857-2200 Home

ADDRESS PO BOX 2257 ASHEBORO, NC 27204

LOCATION 115(N) - TR BRANCHWOOD - TL RIVERFIELD - ON RT NEAR END

SUBDIVISION RIDGECREST BLOCK / SECTION II LOT 99 LOT AREA .67AC SITE CLASS. PS DESIGN FLOW 300GPD L.T.A.R. .136PC/FT2

Septic Tank: 1000 Gallons; STB 1007 Date 6/21/05

Pump Tank: Gallons; PT Date

Pump Make: Model Serial No.

Nitrification Field: No Fields 1 Square Feet 900 Linear Feet 300

No Lines 3@100' Trench Width 36" Max Trench Bottom Depth 36" Gravel Depth N/A

☑ New System ☐ Repair System Type: I, II, III, IV, V, VI

System Description: GRAVITY 25% REDUCTION

Repair System Description: LP PANEL

Maintenance Agreement Required: ☐ Yes ☑ No

☑ House/Mod. Home No. Bedrooms 3

☐ Mobile Home No. Bathrooms 2

☐ Business No. Employees

☐ Other


☐ Slab ☑ Crawl Space ☐ Basement w/plumbing ☐ Basement wo/plumbing

Water Supply: ☐ Individual ☑ Public ☐ Community

Comments:/Conditions:


Comments:/Conditions: ST W/ MARKER AND 2 ABC FILTER INSTALLED WITH 75 QUICK-4 INFILTRATORS.

INITIAL SITE SKETCH 1"=50'

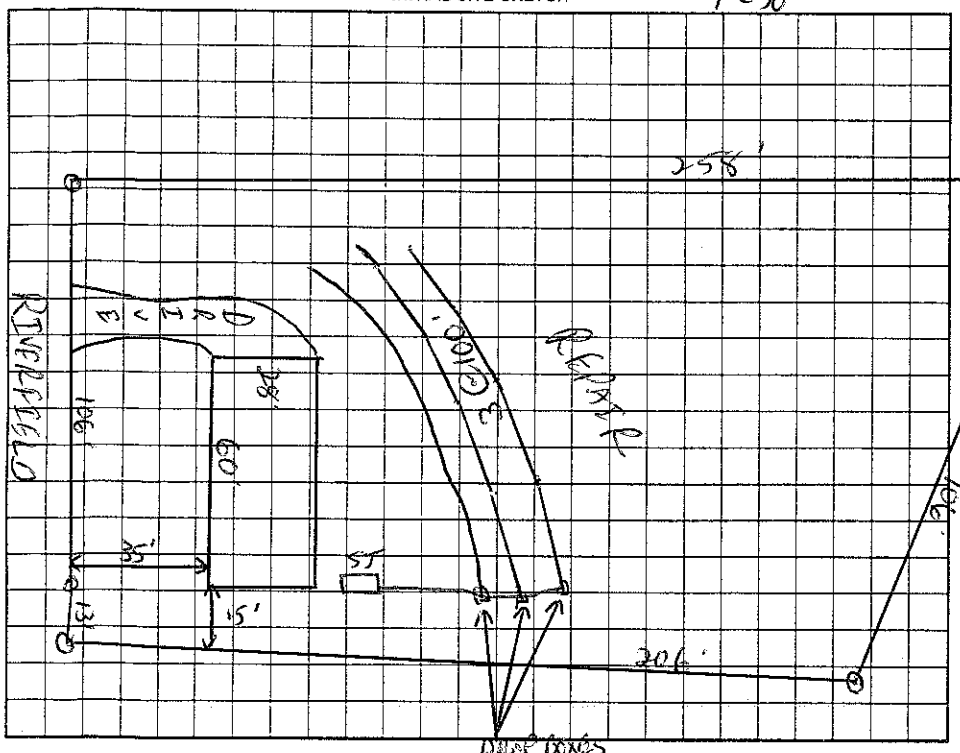

AS BUILT SKETCH

INSTALLED AS DRAWN

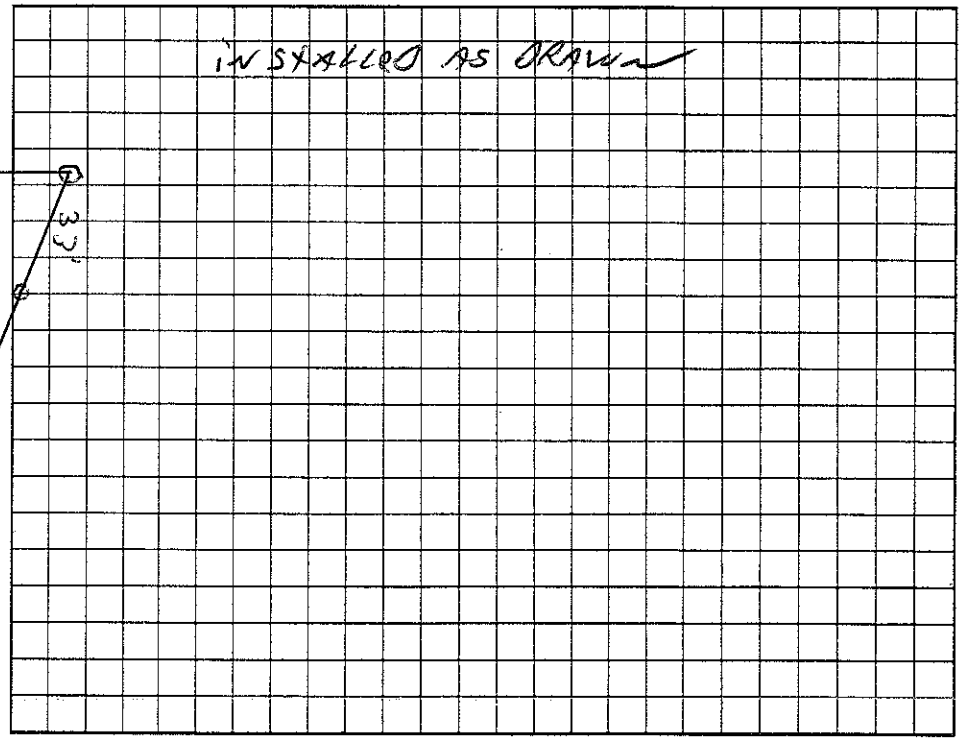

Permit can be suspended or revoked if any false information is supplied toward securing the permit/any unauthorized changes are made to the site/any unauthorized changes are made in the installation of the system. Improvement Permit with plat valid without expiration. Improvement Permit with site plan valid for sixty months. Authorization to Construct is valid for a period equal to that of Improvement Permit – not to exceed sixty months.

Signed: Phil Craven date

Improvement Permit by: CS date 8/31/04

Authorization to Construct by: date 8/22/05

Installed by: STEVE BRYANT

Operation Permit by: date 8/26/05

Existing System Inspection by: date

HEALTH DEPT. COPY: WHITE OWNER COPY (FINAL): YELLOW OWNER COPY (INITIAL): PINK