IREDELL COUNTY HEALTH DEPARTMENT

STATESVILLE 704-878-5305 MOORESVILLE 704-664-5281

IMPROVEMENT PERMIT / CERTIFICATE OF COMPLETION / OPERATION PERMIT / EXISTING SYSTEM INSPECTION

PROPERTY DESCRIPTION NO. REPAIR DATE 6/24/93 TAX MAP NO. REPAIR

OWNER OR CONTRACTOR BRENDA WARREN PHONE: Business Home

ADDRESS

LOCATION NC 115 N, TL HILL DAIRY ROAD, 6TH HOUSE ON (R) SITE CLASS. PS L.T.A.R. 0.4 GPD/FT

SUBDIVISION BLOCK / SECTION LOT LOT AREA AMPLE

Water Supply: ☐ Individual ☐ Community ☐ Public WELL

Septic Tank: EXISTING Gallons; STB Date

Pump Tank: Gallons; PT Date

Nitrification Field: No Fields 1 Square Feet 150 Linear Feet 50

No Lines 1 Trench Width 36" Trench Depth 36" Gravel Depth 18"

☐ New System ☒ Repair System Type: I. II (III) IV. V. VI

System Description:

Repair System Description: CONV, GRAVITY

Maintenance Agreement Required: ☐ Yes ☒ No

☒ House/Mod. Home No. Bedrooms 3

☐ Mobile Home No. Bathrooms 2

☐ Business No. Employees

☐ Other

Garbage Disposal: ☐ Yes ☒ No

Auto. Dishwasher: ☒ Yes ☐ No


Auto. Washing Machine: ☒ Yes ☐ No

Other


☐ Slab ☒ Crawl Space ☐ Basement w/plumbing ☐ Basement wo/plumbing

Comments (1) SEPTIC TANK PUMPED OUT
(2) NEW SANITARY TEE INSTALLED IN TANK
(3) PIPE GUTTER DRAINS AWAY FROM SYSTEM

INITIAL SITE SKETCH

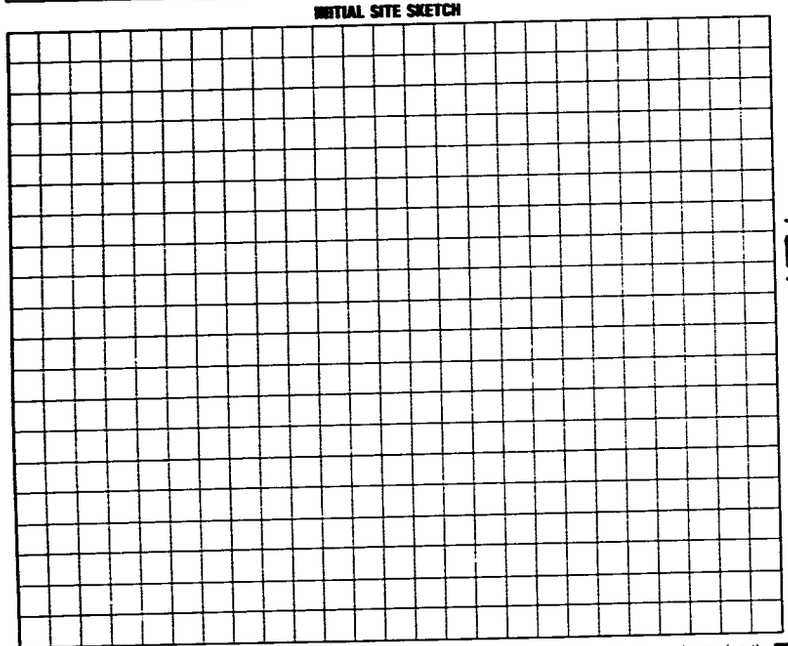

AS BUILT SKETCH

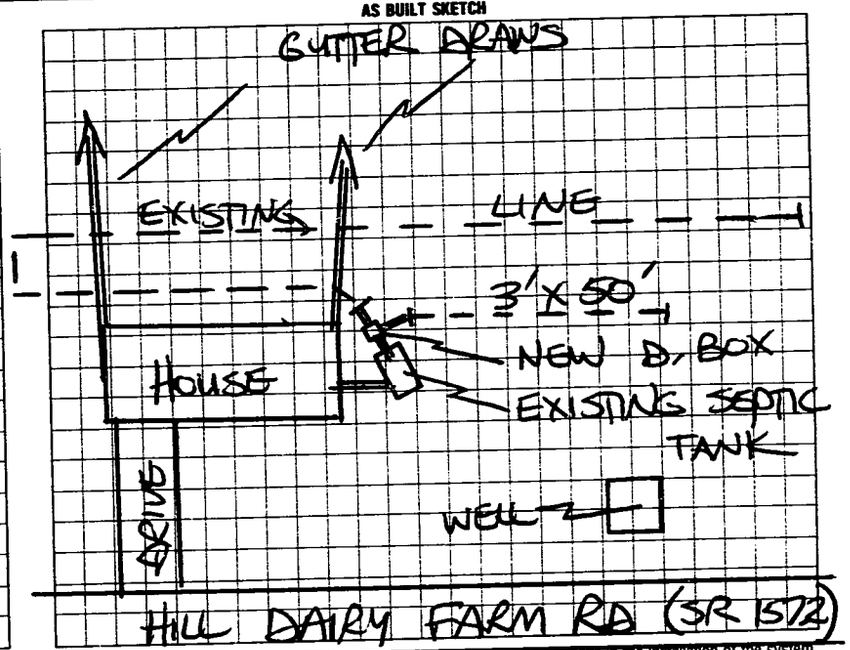

I understand that this permit can be suspended or revoked if any false information is supplied toward securing the permit/any unauthorized changes are made to the site/any unauthorized changes are made in the installation of the system. Improvement Permit is valid for 60 months from date of issuance.

Signed:

Improvement Permit by: STEVE HEDRICK date 4/21/93

Existing System Inspection by: date

Installed by: JAMES HUALEY

Certificate of Completion by: STEVE HEDRICK date 6/24/93

Operation Permit by: date

HEALTH DEPT. COPY: WHITE INSPECTION COPY (FINAL): GREEN OWNER COPY (FINAL): YELLOW INSPECTION COPY (INITIAL): PINK OWNER COPY (INITIAL): GOLD