IREDELL COUNTY HEALTH DEPARTMENT

STATESVILLE 704-878-5305 MOORESVILLE 704-664-5281

IMPROVEMENT PERMIT / CERTIFICATE OF COMPLETION / OPERATION PERMIT / EXISTING SYSTEM INSPECTION

PROPERTY DESCRIPTION NO. REPAIR DATE 6/24/93 TAX MAP NO. REPAIR

OWNER OR CONTRACTOR WILLIAM WARREN PHONE: Business Home

ADDRESS

LOCATION NC115N, TL HILL DAIRY ROAD, 5TH HOUSE ON (R) PS

SUBDIVISION BLOCK / SECTION LOT LOT AREA AMPLE SITE CLASS. L.T.A.R. 0.4 GAD/FT²

Water Supply: ☑ Individual ☐ Community ☐ Public WELL

Septic Tank: EXISTING Gallons: STB Date

Pump Tank: Gallons: PT Date

Nitrification Field: No. Fields 2 Square Feet 240 Linear Feet 80

No. Lines 1 Trench Width 36" Trench Depth 36" Gravel Depth 18"

☐ New System ☑ Repair System Type: I. II (III) IV. V. VI

System Description:

Repair System Description: CONV, GRAVITY

Maintenance Agreement Required: ☐ Yes ☑ NO

☐ House/Mod. Home No. Bedrooms 4

☐ Mobile Home No. Bathrooms 1

☐ Business No. Employees

☐ Other

☐ Slab ☑ Crawl Space ☐ Basement w/plumbing ☐ Basement wo/plumbing

Garbage Disposal: ☐ Yes ☑ No

Auto. Dishwasher: ☑ Yes ☐ No


Auto. Washing Machine: ☑ Yes ☐ No

Other

Comments ① SEPTIC TANK PUMPED OUT INSPECTED IN TANK.
② NEW SANITARY TEE

INITIAL SITE SKETCH

AS BUILT SKETCH

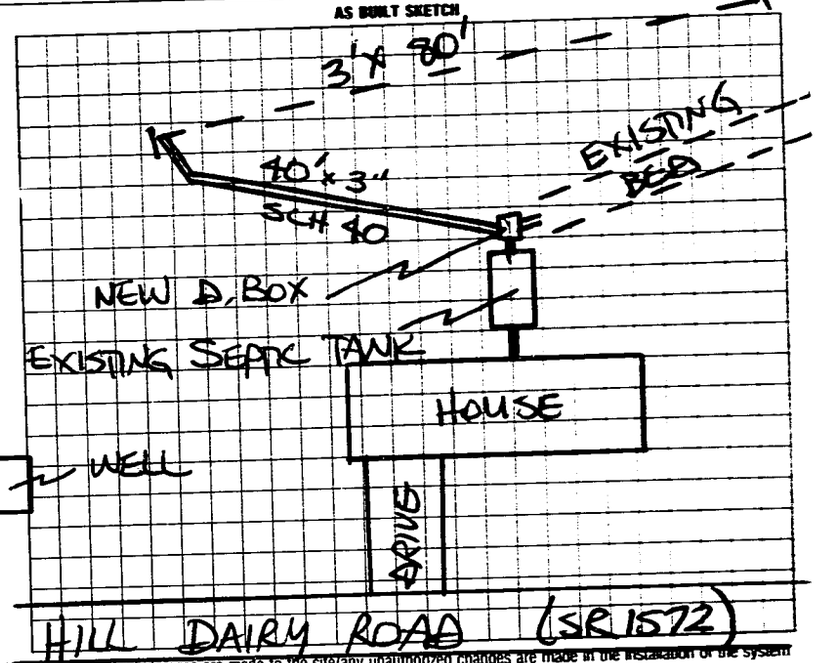

I understand that this permit can be suspended or revoked if any false information is supplied toward securing the permit/any unauthorized changes are made to the site/any unauthorized changes are made in the installation of the system. Improvement Permit is valid for 60 months from date of issuance.

Signed:

Improvement Permit by: STEVE HEDRICK date 4/20/93

Existing System Inspection by: date

Installed by: JAMES HUNTER

Certificate of Completion by: STEVE HEDRICK date 6/24/93

Operation Permit by: date

HEALTH DEPT. COPY: WHITE INSPECTION COPY (FINAL): GREEN OWNER COPY (FINAL): YELLOW INSPECTION COPY (INITIAL): PINK OWNER COPY (INITIAL): GOLD