* [redacted] Expansion

(C1)

IREDELL COUNTY HEALTH DEPARTMENT

STATESVILLE 704-878-5305 MOORESVILLE 704-664-5281

IMPROVEMENT PERMIT / AUTHORIZATION TO CONSTRUCT / OPERATION PERMIT / EXISTING SYSTEM INSPECTION

PERMIT# 14103 PIN# 4729-03-0619 DATE 21 March 07

OWNER OR APPLICANT Mark Welborn PHONE: Business 704-876-6772 Home

ADDRESS 142 Fox Run Dr. Statesville

LOCATION 115 N to County Life Estate. Go to Stop TL - Go to End - TR - Go to End

SUBDIVISION County Life Estate BLOCK / SECTION #1 LOT 55+56 LOT AREA .75 AC SITE CLASS. PS DESIGN FLOW 360 gpd L.T.A.R. 0.25 ft²/ld

Septic Tank: Gallons: STB Date

Pump Tank: Gallons: PT Date

Pump Make: Model Serial No.

Nitrification Field: No Fields 1 Square Feet 600 Linear Feet 150

No Lines 2 Trench Width 36" Max Trench Bottom Depth 36"

☐ New System ☑ Repair ☑ Expansion System Type: I II III IV V VI

System Description: 25% Reduction

Repair System Description: 50% Reduction Pressure

Maintenance Agreement Required: ☐ Yes ☑ No

Gravel Depth N/A ☑ Gravity ☐ Pressure

☑ House/Mod. Home No. Bedrooms 3

☐ Mobile Home No. Persons

☐ Business No. Employees

☐ Other


Water Supply: ☐ Individual ☑ Public ☐ Community

☐ Slab ☑ Crawl Space ☐ Basement w/plumbing ☐ Basement wo/plumbing


Comments:/Conditions: Follow contour / Keep 50' from Stream / Add Deep-bury and 600 ft2

Comments:/Conditions:

INITIAL SITE SKETCH

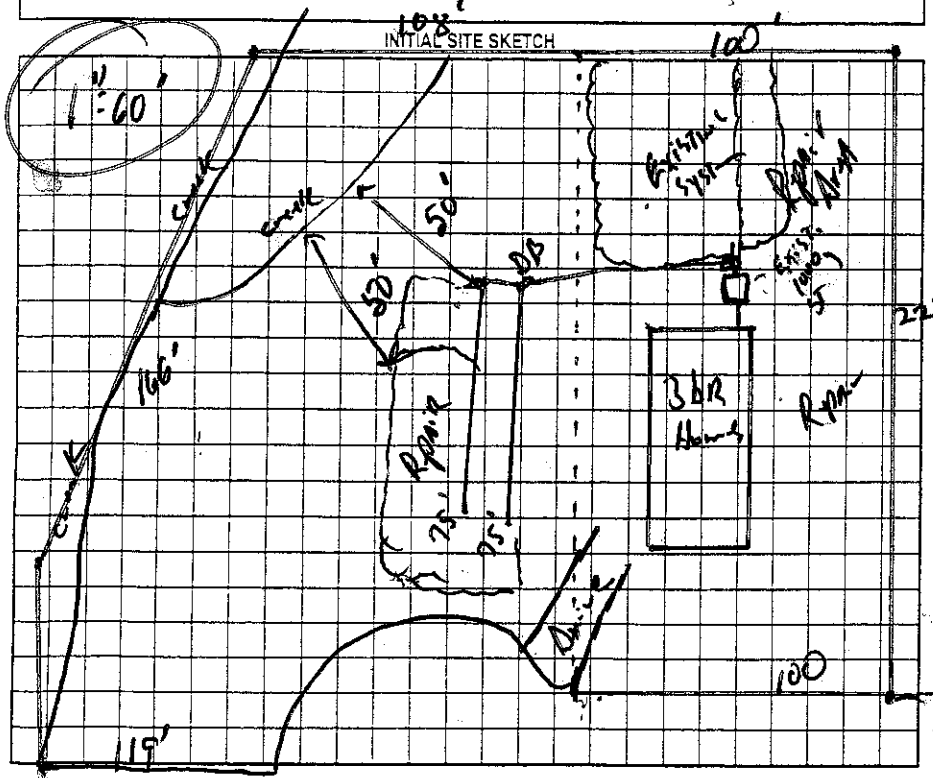

AS BUILT SKETCH

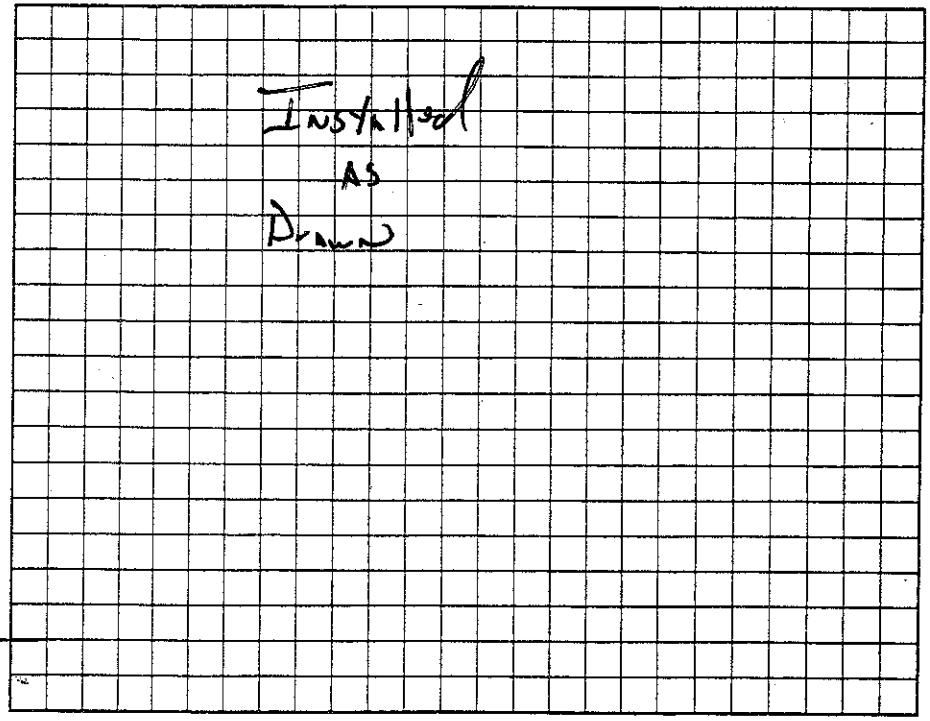

Permit can be suspended or revoked if any false information is supplied toward securing the permit/any unauthorized changes are made to the site/any unauthorized changes are made in the installation of the system. Improvement Permit with plat valid without expiration. ☐ Improvement Permit with site plan valid for sixty months ☐ Authorization to Construct is valid for a period equal to that of Improvement Permit – not to exceed sixty months.

Signed: date

Improvement Permit by: R.S. date 17 Apr 07

Authorization to Construct by: R.S. date 17 Apr 07

Installed by: Jim Abee

Operation Permit by: R.S. date 10 May 07

Existing System Inspection by: date

HEALTH DEPT. COPY: WHITE OWNER COPY (FINAL): YELLOW OWNER COPY (INITIAL): PINK