IMPROVEMENT PERMIT / ~~CERTIFICATE OF COMPLETION~~ / OPERATION PERMIT / EXISTING SYSTEM INSPECTION

PROPERTY DESCRIPTION NO. 23848 DATE 6/20/96 TAX MAP NO. 14E-5-A-55 & 56 Watershed: ☐ Yes ☐ No

OWNER OR CONTRACTOR Mark Weibore PHONE: Business _____ Home 871-0498

ADDRESS 712 W. Pine Circle Statesville 28677

LOCATION W/S Rt on Candy Lee Estates Lt on Tulip, Rt on Fox Run, Lot at End on Rt

SUBDIVISION Candy Lee Estates BLOCK / SECTION _____ LOT 55 & 56 LOT AREA _____ SITE CLASS. _____ DESIGN FLOW _____ L.T.A.R. _____

Septic Tank: 1000 Gallons; STB 1012 Date 1-24-97

Pump Tank: _____ Gallons; PT _____ Date _____

Pump Make: _____ Model _____ Serial No. _____

Nitrification Field: No Fields I Square Feet 594 Linear Feet 198

No Lines 3 Trench Width 36" Max Trench Bottom Depth 24" Gravel Depth N/A

☑ New System ☐ Repair System Type: I. II. III. IV. V.

System Description: Groveless System (Graf)

Repair System Description: Pressure Dosed (Geau?)

Maintenance Agreement Required: ☐ Yes ☑ No

☑ House/Mod. Home ☐ Mobile Home ☐ Business ☐ Other

No. Bedrooms 2 No. Bathrooms 2 No. Employees _____


☐ Slab ☐ Crawl Space ☐ Basement w/plumbing ☐ Basement wo/plumbing

Water Supply: ☐ Individual ☑ Community ☐ Public


Comments: Groveless System 24" Depth Max. Keep system 10' from rear lot line and 5' from MH. Repair must be pressure dosed. Contour Line is Flagged and Lines must lay on contour

Comments:

INITIAL SITE SKETCH

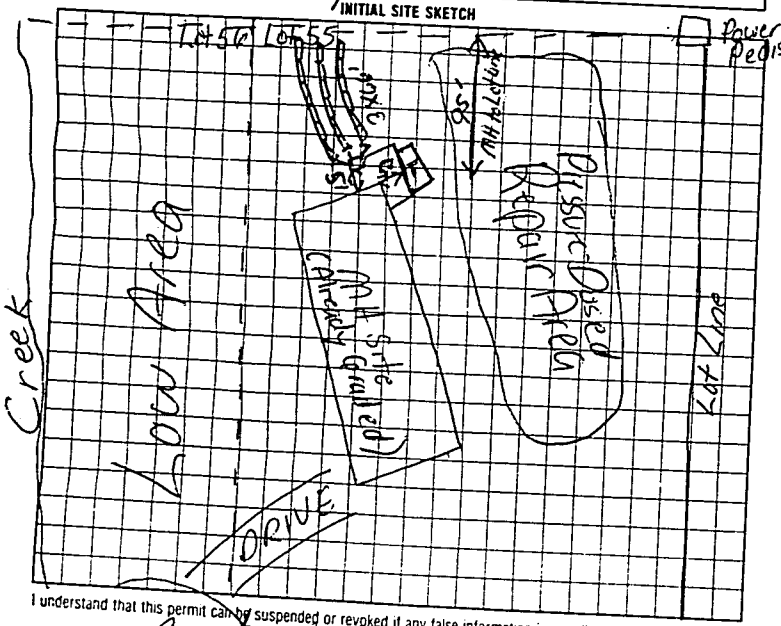

AS BUILT SKETCH

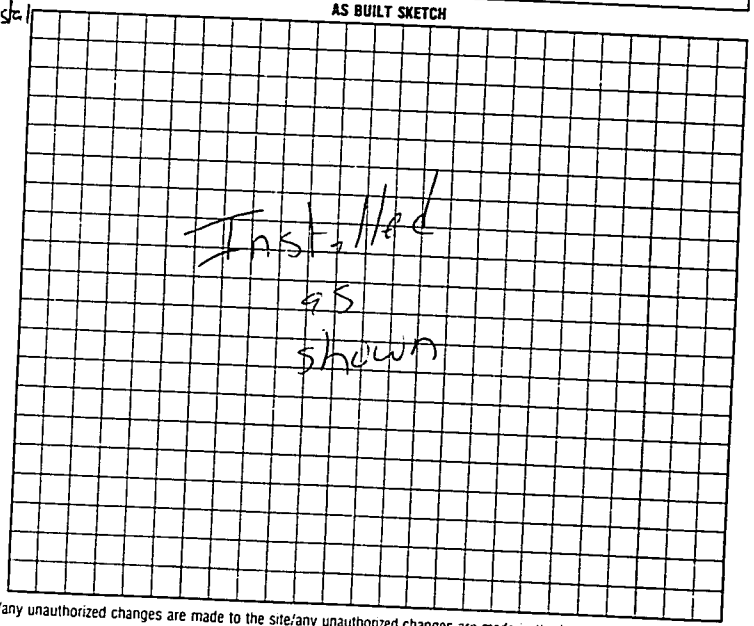

I understand that this permit can be suspended or revoked if any false information is supplied toward securing the permit/any unauthorized changes are made to the site/any unauthorized changes are made in the installation of the system.

Signed Angie Weibore

Improvement Permit by _____ date 6/20/96

Existing System Inspection by _____ date 6/20/96

Authorization to Construct - Valid 60 months from date of Issuance

Installed by: A-1 Backhoe

Certificate of Completion by: _____ date _____

Operation Permit by _____ date 4-10-97

HEALTH DEPT COPY (FINAL) WHITE INSPECTION COPY (FINAL) GREEN OWNER COPY (FINAL) YELLOW INSPECTION COPY (INITIAL) PINK OWNER COPY (INITIAL) GOLD