Authorization To Construct

64015

IREDELL COUNTY HEALTH DEPARTMENT

STATESVILLE 704-878-5305 MOORESVILLE 704-664-5281

IMPROVEMENT PERMIT / ~~CERTIFICATE OF COMPLETION~~ / OPERATION PERMIT / EXISTING SYSTEM INSPECTION

PROPERTY DESCRIPTION NO. 24493 DATE 9/17/96 TAX MAP NO. 14E-5-A-51 Watershed: ☐ Yes ☑ No

OWNER OR CONTRACTOR Olde Towne Mobile Homes PHONE: Business 873-1481 Home

ADDRESS PO Box 293 Union Grove

LOCATION 115 N, Left to Country Life Estates, Lt at End, Rt at End, 2nd Lot on Rt

SUBDIVISION Country Life Estates BLOCK / SECTION LOT 51 LOT AREA 22,500' SITE CLASS 1Fa DESIGN FLOW 300 gpd L.T.A.R. 0.3 gpd/ft²

Septic Tank: 1000 Gallons; STB 1012 Date 7-2-96

Pump Tank: Gallons; PT Date

Pump Make: Model Serial No.

Nitrification Field: No Fields 1 Square Feet 900 Linear Feet 300

No Lines 4 Trench Width 36" Max Trench Bottom Depth 36"

☑ New System ☐ Repair System Type: I II III IV V VI

System Description: Chambered Gravity

Repair System Description: Chambered Gravity

Maintenance Agreement Required: ☐ Yes ☑ No

Gravel Depth N/A ☐ Slab ☐ Crawl Space ☐ Basement w/plumbing ☐ Basement wo/plumbing

☐ House/Mod. Home ☑ Mobile Home ☐ Business ☐ Other


No. Bedrooms 3 No. Bathrooms 2 No. Employees

Water Supply: ☐ Individual ☐ Community ☑ Public


Comments: System Flagged On Site. MH must sit as indicated on property

Comments:

1" = 30' INITIAL SITE SKETCH

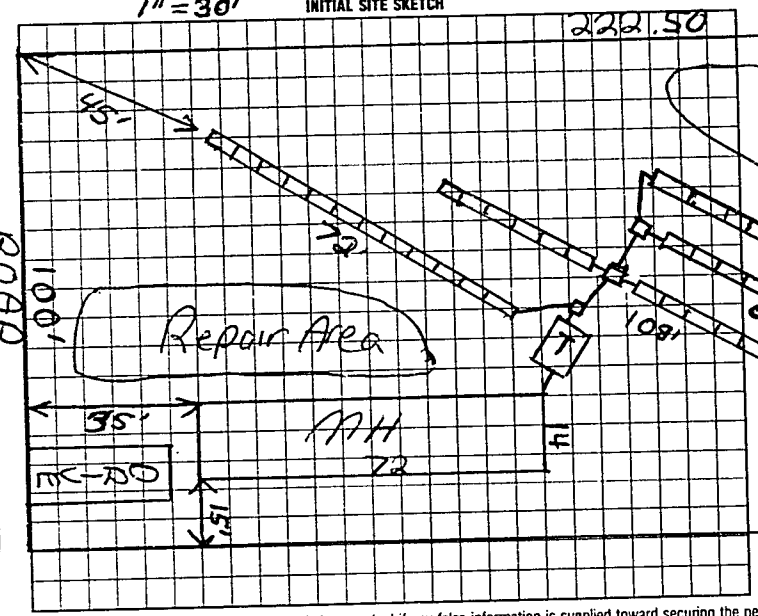

AS BUILT SKETCH

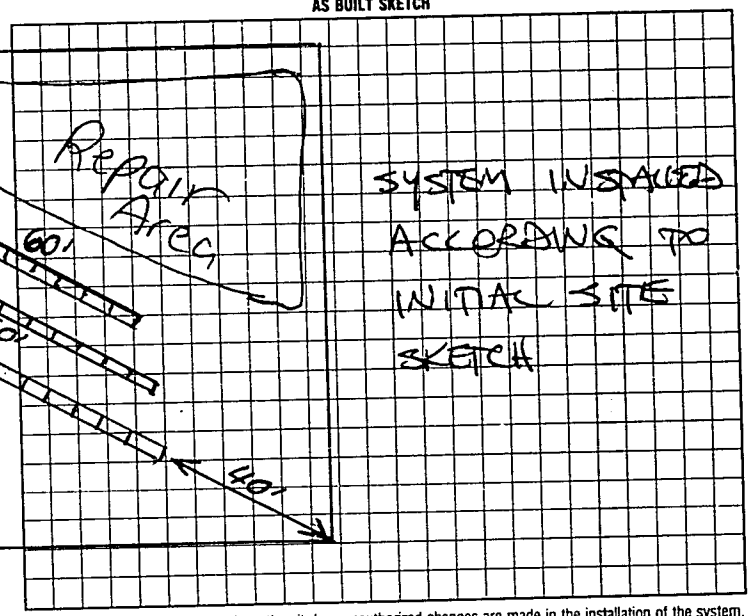

SYSTEM INSTALLED ACCORDING TO INITIAL SITE SKETCH

I understand that this permit can be suspended or revoked if any false information is supplied toward securing the permit/any unauthorized changes are made to the site/any unauthorized changes are made in the installation of the system.

Authorization To Construct Valid 5 years From Date of Issuance

Signed E. L. Sheets

Improvement Permit by: Kelly R. Sheets date 9/17/96

Authorization To Construct by: Kelly R. Sheets date 9/17/96

Installed by: JEFF HURLBUT date

Certificate of Completion by: date

Operation Permit by: STEVE HEDRICK date 11-6-96

HEALTH DEPT. COPY: WHITE INSPECTION COPY (FINAL): GREEN OWNER COPY (FINAL): YELLOW INSPECTION COPY (INITIAL): PINK OWNER COPY (INITIAL): GOLD

9071100