(O-585-2454) 9:30-1000

IREDELL COUNTY HEALTH DEPARTMENT

STATESVILLE 704-878-5305 MOORESVILLE 704-664-5281

IMPROVEMENT PERMIT / AUTHORIZATION TO CONSTRUCT / OPERATION PERMIT / EXISTING SYSTEM INSPECTION

PERMIT# 090544 PIN# 4729 04 1833 DATE 7/21/00

OWNER OR CONTRACTOR Janet Lackey PHONE: Business Home 828-635-1033

ADDRESS 1359 Kidd Lackey Rd. Taylorsville, NC. 28681

LOCATION 11.5 N TL Estate Dr., on (L) before last trailer

SUBDIVISION JOHN KING EST. BLOCK / SECTION LOT 8 LOT AREA .47 AC SITE CLASS RS DESIGN FLOW 360 L.T.A.R. 35

Septic Tank: 1000 Gallons; STB 1012 Date 5/30/00
Pump Tank: Gallons; PT Date
Pump Make: Model Serial No.
Nitrification Field: No Fields 1 Square Feet 1028 Linear Feet 340
No Lines 5 @ 68' Trench Width 36" Max Trench Bottom Depth 36" Gravel Depth 12"

[X] New System [ ] Repair System Type: I (II) III IV V VI
System Description: Over - Conventional
Repair System Description: Same
Maintenance Agreement Required: [ ] Yes [X] No


[ ] House/Mod. Home No. Bedrooms 3
[X] Mobile Home No. Bathrooms 2
[ ] Business No. Employees
[ ] Other
[ ] Slab [X] Crawl Space [ ] Basement w/plumbing [ ] Basement wo/plumbing

Water Supply: [ ] Individual [ ] Public [X] Community IREDELL


Comments:/Conditions: Subsurface Farm Drain required upslope from system.

Comments:/Conditions: 8/28/00 - Built except a 5 shaped diversion ditch in the same location shown on the AS Built

(1"=40') INITIAL SITE SKETCH

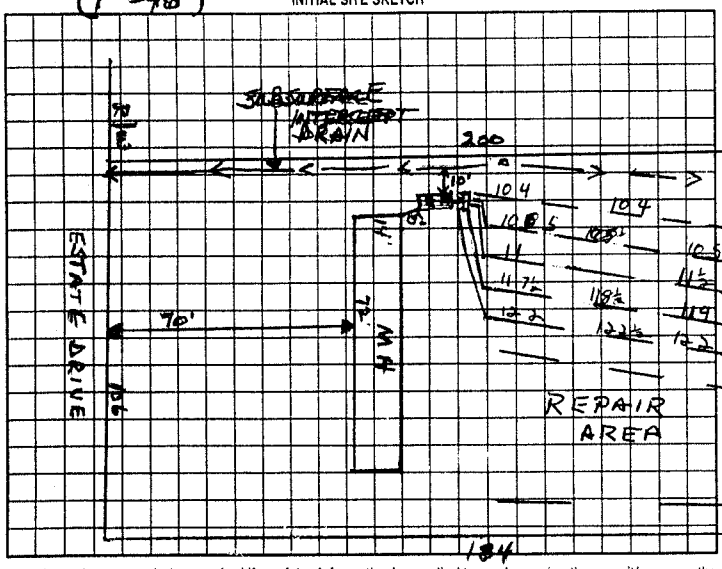

AS BUILT SKETCH

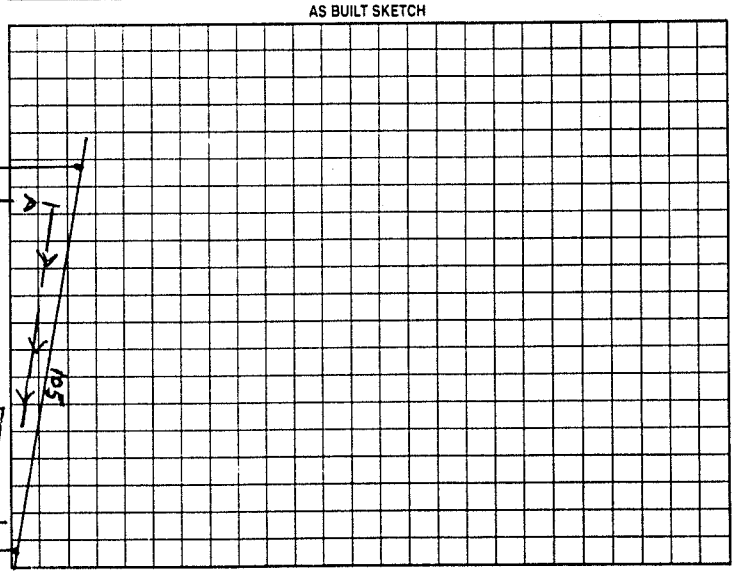

Permit can be suspended or revoked if any false information is supplied toward securing the permit/any unauthorized changes are made to the site/any unauthorized changes are made in the installation of the system. Improvement Permit with plat valid without expiration. Improvement Permit with site plan valid for sixty months. Authorization to Construct is valid for a period equal to that of Improvement Permit – not to exceed sixty months.

Signed: Kristen Klages date 7/21/00 Installed by: Foothills Plumbing Co.

Improvement Permit by: Wesley Sparks RS. date 7/20/00 Operation Permit by: C. [signature] RS date 8/31/00

Authorization to Construct by: Wesley Sparks RS. date 7/20/00 Existing System Inspection by: date

HEALTH DEPT. COPY: WHITE OWNER COPY (FINAL): YELLOW OWNER COPY (INITIAL): PINK