IREDELL COUNTY HEALTH DEPARTMENT

STATESVILLE 704-878-5305 MOORESVILLE 704-664-5281

IMPROVEMENT PERMIT / AUTHORIZATION TO CONSTRUCT / OPERATION PERMIT / EXISTING SYSTEM INSPECTION

PERMIT# 040898 PIN# 4729-04-3838 DATE 8/3/00

OWNER OR CONTRACTOR Brenda Taylor PHONE: Business Home 876-3003

ADDRESS 337 Ford Farm Rd Statesville NC 28625

LOCATION Hwy 115 N, TL Estate Dr, .1B mile on Lt

SUBDIVISION John S Key Sub BLOCK / SECTION - LOT 6+7 LOT AREA ≥ 40,000 ft² SITE CLASS. PS DESIGN FLOW 360 L.T.A.R. 0.25

Septic Tank: 1000 Gallons: STB 312 Date 6-31-00
Pump Tank: Gallons: PT Date
Pump Make: Model Serial No.
Nitrification Field: No Fields 1 Square Feet 1440 Linear Feet 480
No Lines 6@80' Trench Width 36" Max Trench Bottom Depth 36"

[X] New System [ ] Repair System Type: I (II) III, IV, V, VI
System Description: Gravity conventional
Repair System Description: Same
Maintenance Agreement Required: [ ] Yes [X] No
Gravel Depth 12" [ ] Slab [X] Crawl Space [ ] Basement w/plumbing [ ] Basement w/o plumbing


[ ] House/Mod. Home No. Bedrooms 3
[X] Mobile Home No. Bathrooms 2
[ ] Business No. Employees
[ ] Other

Water Supply: [X] Individual [ ] Public [ ] Community


Comments/Conditions: Keep well minimum of 50' from system - Install lines on Contour 1:60 Scale

Comments/Conditions: County water at 115 Not S down this road

INITIAL SITE SKETCH

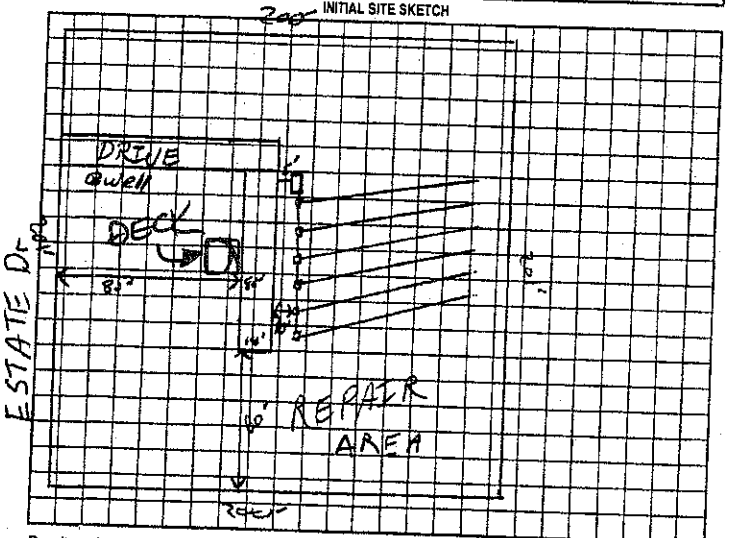

AS BUILT SKETCH

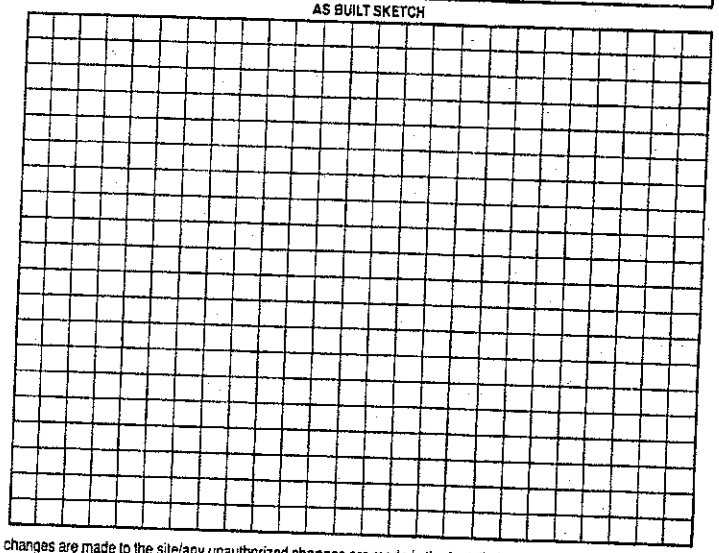

Permit can be suspended or revoked if any false information is supplied toward securing the permit/any unauthorized changes are made to the site/any unauthorized changes are made in the installation of the system. Improvement Permit with plat valid without expiration. Improvement Permit with site plan valid for sixty months. Authorization to Construct is valid for a period equal to that of Improvement Permit – not to exceed sixty months.

Signed: 8-7-00 date 8-7-00

Improvement Permit by: RSE date 8/3/00

Authorization to Construct by: RSE date 8/3/00

Installed by: Tuckers Hauling & Grading

Operation Permit by: date 8-15

Existing System Inspection by: date

HEALTH DEPT. COPY: WHITE OWNER COPY (FINAL): YELLOW OWNER COPY (INITIAL): PINK

Location of the proposed FRONT DECK 12'x12' addition does not appear to impact the existing on-site septic system.**NOTE: DECK IN FRONT of MH

R. STEVE HEDRICK REHS

Date: MAY 8, 2012

ICHD-Environmental Health Division

TW