61808

IREDELL COUNTY HEALTH DEPARTMENT

STATESVILLE 704-878-5305 MOORESVILLE 704-664-5281

IMPROVEMENT PERMIT / CERTIFICATE OF COMPLETION / OPERATION PERMIT / EXISTING SYSTEM INSPECTION

PROPERTY DESCRIPTION NO. 24307 DATE 7-5-96 TAX MAP NO. 14F-5-A-40 Watershed ☐ Yes ☐ No

OWNER OR CONTRACTOR RODNEY B. ROMANS PHONE: Business Home 528-4030

ADDRESS PO Box 1737 MOORESVILLE, NC 28115

LOCATION NC 115 N TL COUNTRY LIFE EST, DRIVE, 6th LOT ON LEFT

SUBDIVISION COUNTRY LIFE BLOCK / SECTION LOT 40 LOT AREA 100X227' SITE CLASS. PS DESIGN FLOW 360 L.T.A.R. 0.30 GPD/FT²

Septic Tank: 1000 Gallons; STB 760 Date 5/18/96

Pump Tank: Gallons; PT Date

Pump Make: Model Serial No.

Nitrification Field: No Fields 1 Square Feet 1200 Linear Feet 400

No Lines 4 Trench Width 36 Max Trench Bottom Depth 18-36" Gravel Depth 12"

☐ New System ☐ Repair System Type: I, II, IV, V, VI

System Description: CONV. GRAVITY

Repair System Description: CHAMBER GRAVITY

Maintenance Agreement Required: ☐ Yes ☒ No

☐ House/Mod. Home ☒ Mobile Home ☐ Business ☐ Other

No. Bedrooms 3 No. Bathrooms 2 No. Employees


☐ Slab ☒ Crawl Space ☐ Basement w/plumbing ☐ Basement wo/plumbing

Water Supply: ☐ Individual ☐ Community ☒ Public


Comments: KEEP WATER LINE MINIMUM 10' FROM SYSTEM

Comments:

INITIAL SITE SKETCH

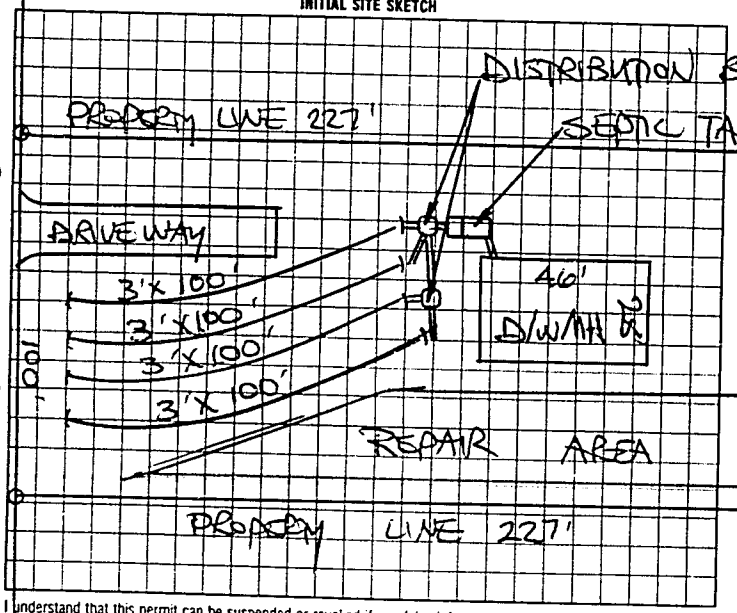

AS BUILT SKETCH

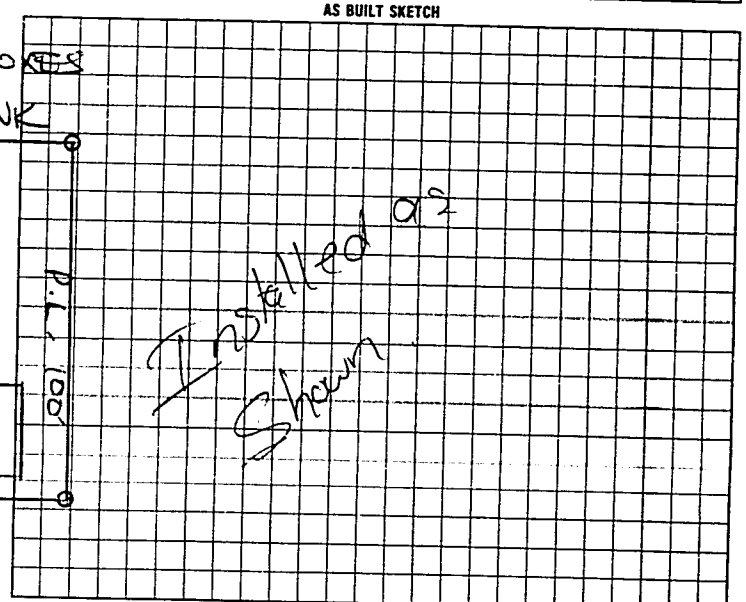

COUNTRY LIFE DRIVE

I understand that this permit can be suspended or revoked if any false information is supplied toward securing the permit/any unauthorized changes are made to the site/any unauthorized changes are made in the installation of the system.

Authorization to Construct is valid five (5) years from date of issuance. Improvement Permit has no expiration date.

Signed: Rodney B. Romans

Improvement Permit by: STEVE HEDRICK date 7-5-96

Evaluation by:

AUTHORIZATION TO CONSTRUCT: STEVE HEDRICK date 7-5-96

Installed by: Rodney B. Romans

Certificate of Completion by:

Operation Permit by: date

date 7/16/96

HEALTH DEPT COPY WHITE | INSPECTION COPY (FINAL) GREEN | OWNER COPY (FINAL) YELLOW | INSPECTION COPY (INITIAL) PINK | OWNER COPY (INITIAL) GOLD

4 0 0 2 0 0