IREDELL COUNTY HEALTH DEPARTMENT

STATESVILLE 704-878-5305 MOORESVILLE 704-664-5281

IMPROVEMENT PERMIT / CERTIFICATE OF COMPLETION / OPERATION PERMIT / EXISTING SYSTEM INSPECTION

PROPERTY DESCRIPTION NO. 066263 DATE 5-12-97 TAX MAP NO. 4729053765

OWNER OR CONTRACTOR DONNIE ESTES PHONE: Business Watershed: ☐ Yes ☑ No

ADDRESS 3941 WILKESBORO HWY, STATESVILLE, NC 28677 Home 876-0526

LOCATION NC 115 N, TR PRIVATE DRIVE, ACROSS FROM OLD TIMERS LANE, BACK OFF ROAD

SUBDIVISION BLOCK / SECTION LOT LOT AREA 2 ACRES SITE CLASS. PS DESIGN FLOW 240 L.T.A.R. 0.30 GPD/FT²

Septic Tank: 1000 Gallons; STB 620 Date 4-29-97

Pump Tank: Gallons; PT Date

Pump Make: Model Serial No.

Nitrification Field: No Fields 1 Square Feet 810 Linear Feet 270

No Lines THREE Trench Width 36" Max Trench Bottom Depth 36" Gravel Depth 12

☑ New System ☐ Repair System Type: ☐ I ☑ II ☐ III, IV, V, VI

System Description: CONVENTIONAL GRAVITY

Repair System Description: CONV. GRAVITY

Maintenance Agreement Required: ☐ Yes ☑ No

☐ House/Mod. Home ☑ Mobile Home ☐ Business ☐ Other

No. Bedrooms 3 No. Bathrooms 2 No. Employees


Water Supply: ☑ Individual ☐ Community ☑ Public WELL NEXT DOOR

☐ Slab ☑ Crawl Space ☐ Basement w/plumbing ☐ Basement wo/plumbing

Comments:

Comments:

INITIAL SITE SKETCH

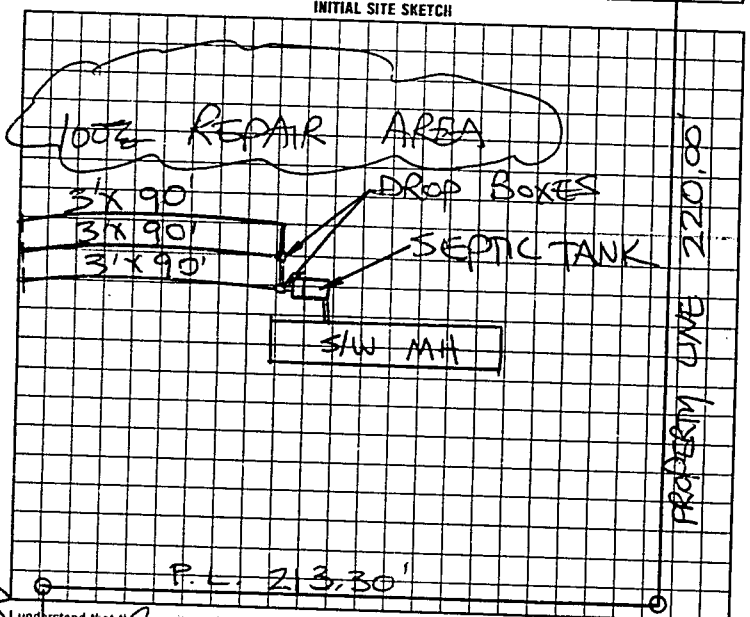

AS BUILT SKETCH

SYSTEM INSTALLED ACCORDING TO INITIAL SITE SKETCH

I understand that this permit can be suspended or revoked if any false information is supplied toward securing the permit/any unauthorized changes are made to the site/any unauthorized changes are made in the installation of the system. Improvement Permit is valid for 60 months from date of issuance. AUTHORIZATION TO CONSTRUCT IS VALID FOR 60 MONTHS FROM DATE OF ISSUANCE

Signed: Roger Livingston

Improvement Permit by: STEVE HEDRICK date 5-12-97

AUTH. TO CONST.

Existing System Inspection by: STEVE HEDRICK date 5-12-97

Installed by: SAMMY REAVIS

Certificate of Completion by: date

Operation Permit by: STEVE HEDRICK date 6-5-97

HEALTH DEPT. COPY: WHITE INSPECTION COPY (FINAL) GREEN OWNER COPY (FINAL) YELLOW INSPECTION COPY (INITIAL) PINK OWNER COPY (INITIAL) GOLD