IREDELL COUNTY HEALTH DEPARTMENT

STATESVILLE 704-878-5305 MOORESVILLE 704-664-5281

IMPROVEMENT PERMIT / CERTIFICATE OF COMPLETION / OPERATION PERMIT / EXISTING SYSTEM INSPECTION

PROPERTY DESCRIPTION NO. 17135 DATE 10/5/93

OWNER OR CONTRACTOR W. G. HOPE PHONE: Business TAX MAP NO. 14E-4-A-16

ADDRESS RT. 11 BOX 274-C STATESVILLE, NC 28677 Home 592-9191

LOCATION NC 115 N TO ESTATE DRIVE, 7TH LOT ON (R)

SUBDIVISION KING ESTATE BLOCK / SECTION LOT 16 LOT AREA AMPLE SITE CLASS. PS L.T.A.R. 0.4 GPD/FT.

Water Supply: ☑ Individual ☐ Community ☐ Public WELL

Septic Tank: 1000 Gallons; STB 1012 Date 8/2/93

Pump Tank: Gallons; PT Date

Nitrification Field: No Fields 1 Square Feet 900 Linear Feet 300

No. Lines 6 Trench Width 36" Trench Depth 18-36 Gravel Depth 12"

☑ New System ☐ Repair System Type: I. II. III. IV. V. VI

System Description: CONV. GRAVITY

Repair System Description: CONV. GRAVITY

Maintenance Agreement Required: ☐ Yes ☑ No

☐ House/Mod. Home ☑ Mobile Home ☐ Business ☐ Other


No. Bedrooms 3 No. Bathrooms 2 No. Employees

Garbage Disposal: ☐ Yes ☑ No Auto. Dishwasher: ☑ Yes ☐ No Auto. Washing Machine ☑ Yes ☐ No Other

☐ Slab ☑ Crawl Space ☐ Basement w/plumbing ☐ Basement wo/plumbing

Comments: (1) KEEP SYSTEM MINIMUM 5' FROM MH, 10' FROM PROPERTY LINE & 50' FROM WELL (2) INSTALL LINES ON CONTOUR USING DROP BOX DISTRIBUTION, NO DEEPER THAN 36", 9' APART ON CENTER

INITIAL SITE SKETCH

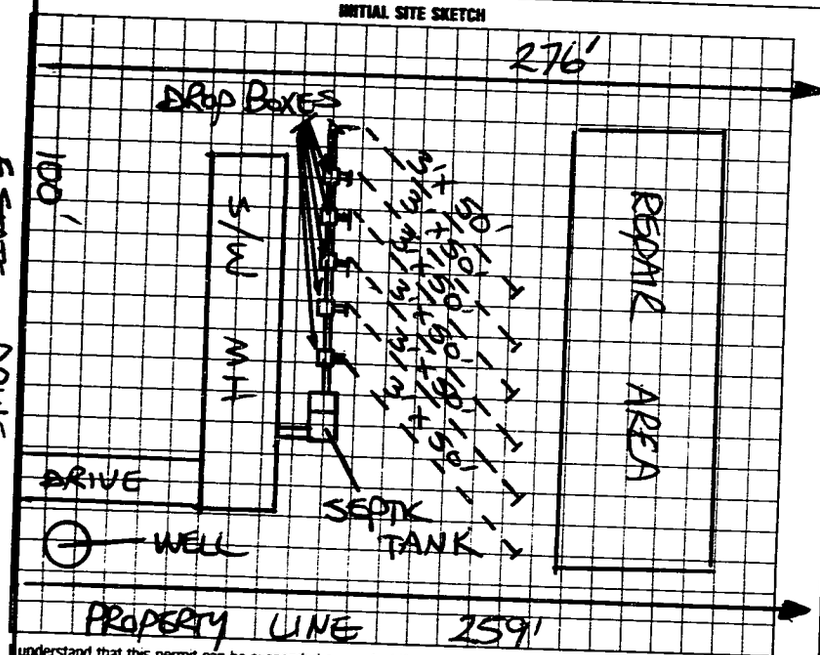

AS BUILT SKETCH

SYSTEM INSTALLED ACCORDING TO INITAL SITE SKETCH

I understand that this permit can be suspended or revoked if any false information is supplied toward securing the permit/any unauthorized changes are made to the site/any unauthorized changes are made in the installation of the system. Improvement Permit is valid for 60 months from date of issuance.

Signed: W. G. Hope

Improvement Permit by: STEVE HEDRICK date 10/5/93

Existing System Inspection by: date

Installed by: FORREST SHUFFORD

Certificate of Completion by: STEVE HEDRICK date 10/27/93

Operation Permit by: date

HEALTH DEPT. COPY: WHITE INSPECTION COPY (FINAL): GREEN OWNER COPY (FINAL): YELLOW INSPECTION COPY (INITIAL): PINK OWNER COPY (INITIAL): GOLD