IREDELL COUNTY HEALTH DEPARTMENT

STATESVILLE 704-878-5305 MOORESVILLE 704-664-5281

IMPROVEMENT PERMIT / AUTHORIZATION TO CONSTRUCT / OPERATION PERMIT / EXISTING SYSTEM INSPECTION

PERMIT# 105860 PIN# 4729-05-3880 DATE 5-7-02

OWNER OR CONTRACTOR DONNIE & DIANA ESTES PHONE: Business c/o 704-873-2547 Home

ADDRESS 3941 WILKESBORO HIGHWAY STATESVILLE, NC 28625

LOCATION NC 115 NORTH, TL PONY RUN LANE, BACK OFF ROAD 1100 FEET

SUBDIVISION BLOCK / SECTION LOT LOT AREA 2.000 ACRES SITE CLASS PS DESIGN FLOW 360 L.T.A.R. 0.25 GPD/FT2

Septic Tank: 1000 Gallons: STB 1012 Date 1-8-02

Pump Tank: Gallons: PT Date

Pump Make: Model Serial No.

Nitrification Field: No Fields 1 Square Feet 1440 Linear Feet 480

No Lines SIX Trench Width 36" Max Trench Bottom Depth 36" Gravel Depth 12"

~~New System~~ Repair System Type: I II III IV V VI

System Description: CONVENTIONAL, GRAVITY

Repair System Description: 25% REDUCTION PUMP

Maintenance Agreement Required: Yes ~~No~~

~~House/Mod. Home~~ Mobile Home Business Other

No. Bedrooms 3 No. Bathrooms 2 No. Employees


Slab ~~Crawl Space~~ Basement w/plumbing Basement wo/plumbing

Water Supply: ~~Individual~~ Public Community WELL

Comments:/Conditions:

Comments:/Conditions SEPTIC TANK WITH MARKER INSTALLED USING "POLYLOK" FILTER

INITIAL SITE SKETCH

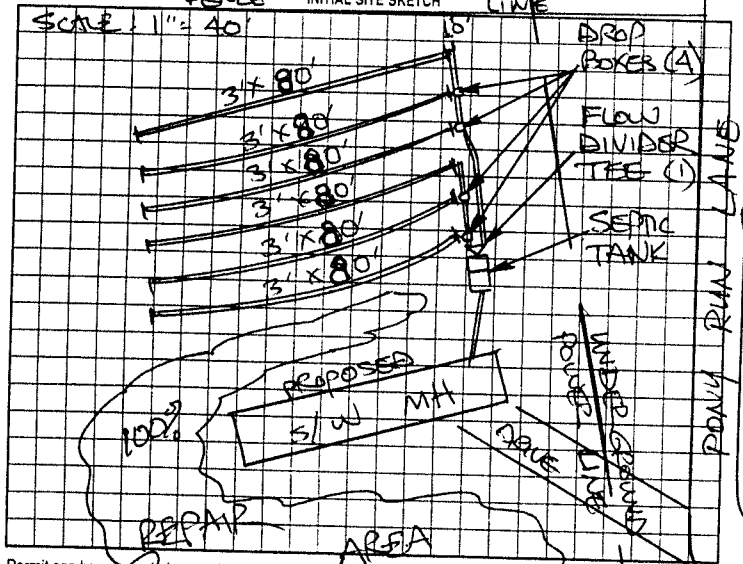

AS BUILT SKETCH

SYSTEM INSTALLED ACCORDING TO INITAL SITE SKETCH

Permit can be suspended or revoked if any false information is supplied toward securing the permit/any unauthorized ~~changes~~ are made to the site, any unauthorized changes are made in the installation of the system. Improvement Permit with plat valid without expiration. Improvement Permit with site plan valid for sixty months. Authorization to Construct is valid for a period equal to that of Improvement Permit – not to exceed sixty months.

Signed: X date 5-7-02

Improvement Permit by: STEVE HEDRICK date 5-7-02

Authorization to Construct by: STEVE HEDRICK date 5-7-02

Installed by: A-1 BACKHOE

Operation Permit by: STEVE HEDRICK date 5-8-02

Existing System Inspection by: date

HEALTH DEPT. COPY: WHITE OWNER COPY (FINAL): YELLOW OWNER COPY (INITIAL): PINK