IREDELL COUNTY HEALTH DEPARTMENT

STATESVILLE 704-878-5305 MOORESVILLE 704-664-5281

IMPROVEMENT PERMIT / AUTHORIZATION TO CONSTRUCT / OPERATION PERMIT / EXISTING SYSTEM INSPECTION

PERMIT# 11536 PIN# 4729-05-~~2782~~ 3933 DATE 8-23-03

OWNER OR CONTRACTOR DONNIE ESTES JR PHONE: Business 336-973-2335 Home 704-876-0526

ADDRESS 3941 Wilkesboro Hwy STATESVILLE, NC 28625

LOCATION 115 N, (L) PONY RUN LANE (R) PAST S/W

SUBDIVISION J.S. KING ESTATES BLOCK / SECTION — LOT — LOT AREA 1.00A SITE CLASS. PS DESIGN FLOW 360 L.T.A.R. .3

Septic Tank: 1000 Gallons; STB 1012 Date 3-7-03

Pump Tank: Gallons; PT Date

Pump Make: Model Serial No.

Nitrification Field: No Fields 1 Square Feet EQ=1200 Linear Feet 300'

No Lines 4x75 Trench Width 36" Max Trench Bottom Depth 36" Gravel Depth N/A

☒ New System ☐ Repair System Type: I, II, (III), IV, V, VI

System Description: GRAV 250 RED

Repair System Description: LP PAVER

Maintenance Agreement Required: ☐ Yes ☒ No

☐ House/Mod. Home ☒ Mobile Home ☐ Business ☐ Other

No. Bedrooms 3 No. Bathrooms 2 No. Employees


☐ Slab ☒ Crawl Space ☐ Basement w/plumbing ☐ Basement wo/plumbing

Water Supply: ☒ Individual ☐ Public ☐ Community


Comments:/Conditions: ① HOUSE & LINES ARE FLAG 600 OUT ② MAINTAIN SETBACKS ③ INSTALL LINES ON CONTOURS

Comments:/Conditions: Tuff-Tite S/Hd + ST marker Installed

INITIAL SITE SKETCH

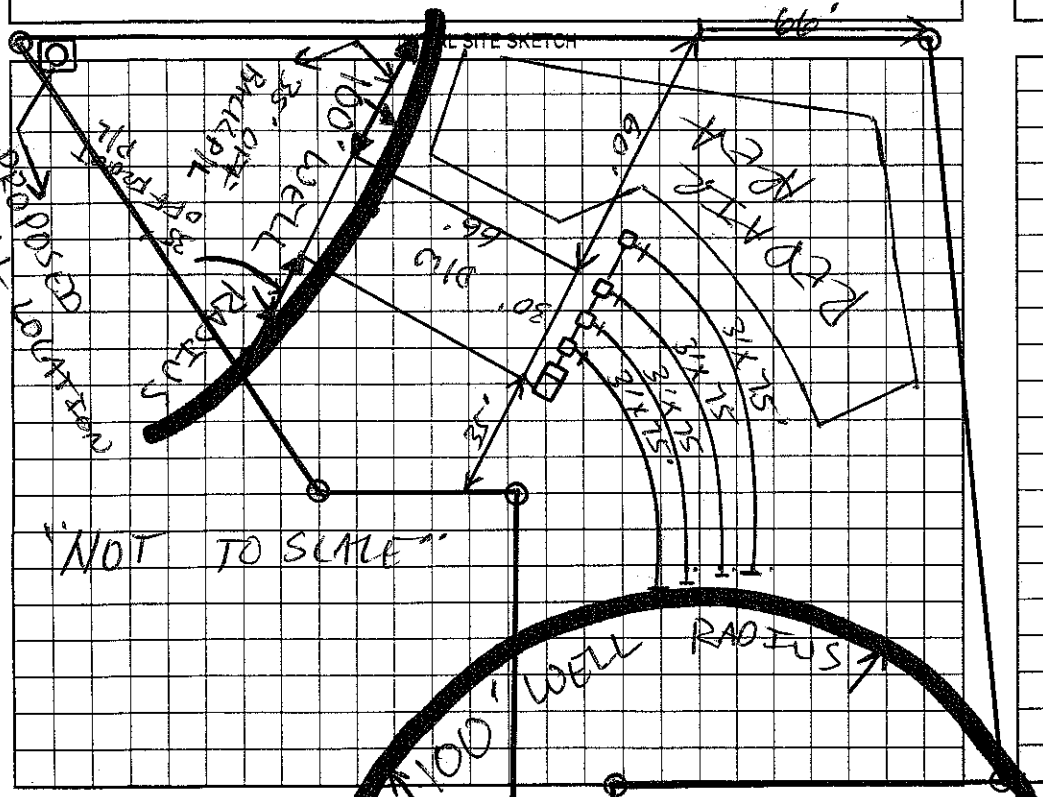

AS BUILT SKETCH

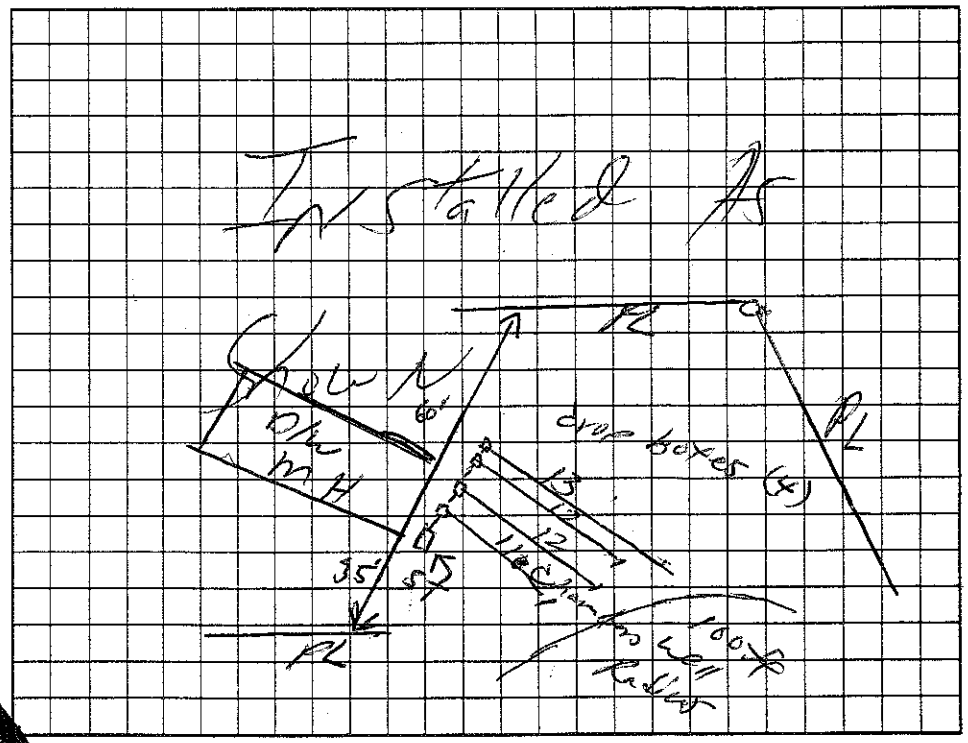

Permit can be suspended or revoked if any false information is supplied toward securing the permit/any unauthorized changes are made to the site/any unauthorized changes are made in the installation of the system. Improvement Permit with plat valid without expiration. Improvement Permit with site plan valid for sixty months. Authorization to Construct is valid for a period equal to that of Improvement Permit – not to exceed sixty months.

Signed: Steve Plumb date 8-20-03 Installed by: A-1 Backhoe

Improvement Permit by: date 8-23-03 Operation Permit by: date 9/17/03

Authorization to Construct by: date 8-23-03 Existing System Inspection by: date

HEALTH DEPT. COPY: WHITE OWNER COPY (FINAL): YELLOW OWNER COPY (INITIAL): PINK

EXIST DUG WELL