IREDELL COUNTY HEALTH DEPARTMENT

STATESVILLE 704-878-5305 MOORESVILLE 704-664-5281

IMPROVEMENT PERMIT / AUTHORIZATION TO CONSTRUCT / OPERATION PERMIT / EXISTING SYSTEM INSPECTION

PERMIT# 084281 PIN# 4729 15 0270 DATE 10-28-99

OWNER OR CONTRACTOR DAVID B. JORDAN PHONE: Business 838-0028 Home 876-6713

ADDRESS 592 BOWLES FARM ROAD, STATESVILLE, NC 28625

LOCATION NC 115 NORTH, TL ESTATE DRIVE, 3RD LOT ON LEFT

SUBDIVISION JOHN S. KING BLOCK / SECTION ____ LOT 20 LOT AREA 0.527 ACRE SITE CLASS: PS DESIGN FLOW 360 L.T.A.R. 0.30 GPD/FT2

Septic Tank: 1000 Gallons; STB 1012 Date 2-3-00
Pump Tank: ____ Gallons; PT ____ Date ____
Pump Make: ____ Model ____ Serial No. ____
Nitrification Field: No Fields 1 Square Feet 1200 Linear Feet 400
No Lines FOUR Trench Width 36" Max Trench Bottom Depth 36" Gravel Depth 12"

☑ New System ☐ Repair System Type: ☐ I ☒ II ☐ III ☐ IV ☐ V ☐ VI
System Description: CONVENTIONAL GRAVITY
Repair System Description: 25% REDUCTION GRAVITY
Maintenance Agreement Required: ☐ Yes ☒ No

☐ House/Mod. Home ☑ Mobile Home ☐ Business ☐ Other
No. Bedrooms 3 No. Bathrooms 2 No. Employees ____


☐ Slab ☑ Crawl Space ☐ Basement w/plumbing ☐ Basement wo/plumbing

Water Supply: ☑ Individual ☐ Public ☐ Community
WELL

Comments/Conditions: ① KEEP SYSTEM MAXIMUM FEASIBLE DISTANCE FROM WELL (60 FEET). ② INSTALL LINES ON CONTOUR AS SHOWN.

Comments/Conditions: SEPTIC TANK WITH RISERS INSTALLED USING "POLYLOK" FILTER

SCALE: 1" = 40' INITIAL SITE SKETCH

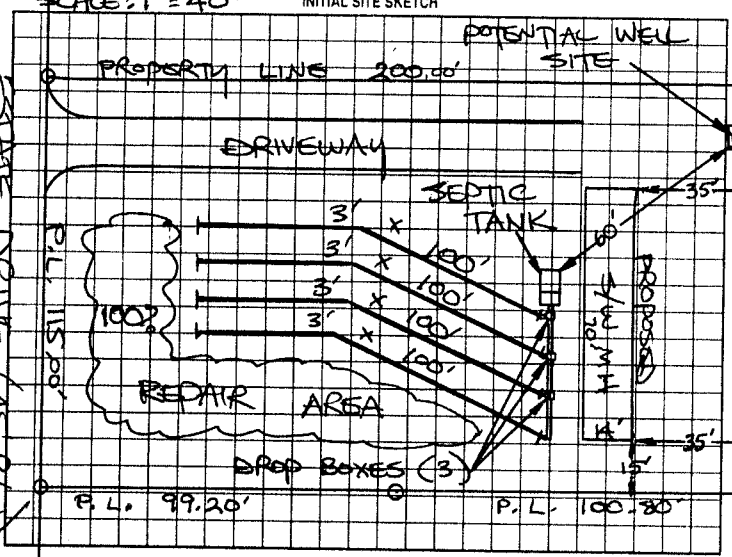

AS BUILT SKETCH

SYSTEM INSTALLED ACCORDING TO INITAL SITE SKETCH

Permit can be suspended or revoked if any false information is supplied toward securing the permit/any unauthorized changes are made to the site/any unauthorized changes are made in the installation of the system. Improvement Permit with plat valid without expiration. Improvement Permit with site plan valid for sixty months. Authorization to Construct is valid for a period equal to that of Improvement Permit – not to exceed sixty months.

Signed: + William M. Jordan date 10-28-99 Installed by: A-1 BACKHOE

Improvement Permit by: STEVE HEDRICK date 10-28-99 Operation Permit by: STEVE HEDRICK date 5-10-00

Authorization to Construct by: STEVE HEDRICK date 10-28-99 Existing System Inspection by: ____ date ____

HEALTH DEPT. COPY: WHITE OWNER COPY (FINAL): YELLOW OWNER COPY (INITIAL): PINK