IREDELL COUNTY HEALTH DEPARTMENT

STATESVILLE 704-878-5305 CI MOORESVILLE 704-664-5281

IMPROVEMENT PERMIT / AUTHORIZATION TO CONSTRUCT / OPERATION PERMIT / EXISTING SYSTEM INSPECTION

PERMIT# 108297 PIN# 4729-05-9690 DATE 8/21/02

OWNER OR CONTRACTOR Bobby Bastle (Robert F. Cook) PHONE Business 828-632-3382 Home —

ADDRESS 1403 Poplar Springs Road Statesville, N.C. 28625

LOCATION Hwy 18 N, to Hanks, Across from Frost Substation

SUBDIVISION — BLOCK / SECTION — LOT 25 LOT AREA 100x436 SITE CLASS — DESIGN FLOW 360 L.T.A.R. Existing

Septic Tank: Existing 1,000 Gallons: STB — Date —

Pump Tank: — Gallons: PT — Date —

Pump Make: — Model — Serial No —

Nitrification Field: No. Fields 1 Square Feet 780 Linear Feet 240

No. Lines 2 x 30 80 Trench Width — Max Trench Bottom Depth — Gravel Depth 12"

☐ New System ☐ Repair System Type: I II III IV V VI

System Description: Existing Conv

Repair System Description: —

Maintenance Agreement Required: ☐ Yes ☒ No

☐ House/Mod. Home ☒ Mobile Home ☐ Business ☐ Other

No. Bedrooms 3 No. Bathrooms 1½ No. Employees —

☐ Slab ☐ Crawl Space ☐ Basement w/plumbing ☐ Basement wo/plumbing


Water Supply: ☒ Individual ☐ Public ☐ Community

Comments/Conditions:

Comments/Conditions: @ Existing System okay at time of Inspection @ Replace S/V with S/V keep New House Sft from Septic System.

INITIAL SITE SKETCH

AS BUILT SKETCH

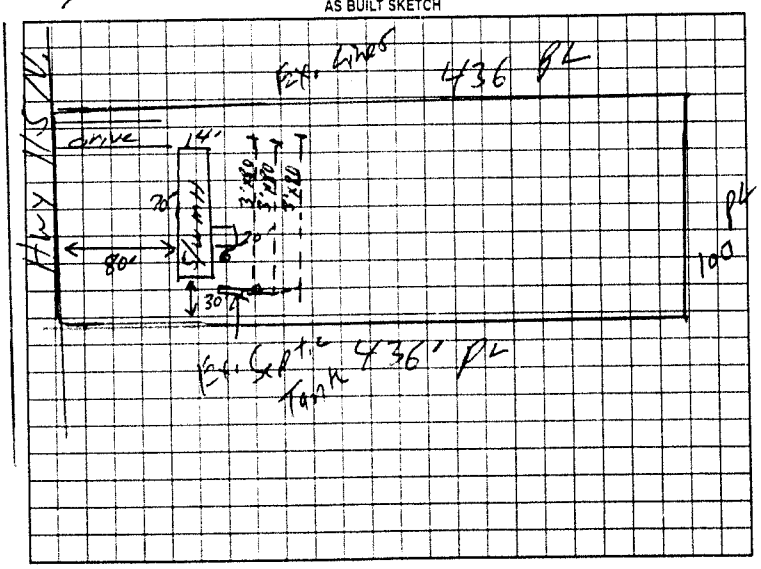

Permit can be suspended or revoked if any false information is supplied toward securing the permit, any unauthorized changes are made to the site, any unauthorized changes are made in the installation of the system. Improvement Permit with plat valid without expiration. Improvement Permit with site plan valid for sixty months. Authorization to Construct is valid for a period equal to that of Improvement Permit - not to exceed sixty months.

Signed: Crystal Duncan date 8-21-02 Installed by —

Improvement Permit by: — date —

Authorization to Construct by: — date —

Operation Permit by — date —

Existing System Inspection by: William O. Johnson date 8/21/02

HEALTH DEPT COPY: WHITE OWNER COPY (FINAL): YELLOW OWNER COPY (INITIAL): PINK