IREDELL COUNTY HEALTH DEPARTMENT

STATESVILLE 704-878-5305 MOORESVILLE 704-664-5281

IMPROVEMENT PERMIT / AUTHORIZATION TO CONSTRUCT / OPERATION PERMIT / EXISTING SYSTEM INSPECTION

PERMIT# 0925606 PIN# 4729 05 9760 DATE 10-25-00

OWNER OR CONTRACTOR IRENE AUSTIN PHONE: Business Home 592-7142

ADDRESS 3925 WILKESBORO Highway, STATESVILLE NC 28625

LOCATION NC 115 N, 5th LOT ON, LEFT PAST ESTATE DRIVE

SUBDIVISION J.S. KING EST. BLOCK / SECTION LOT 26 LOT AREA SITE CLASS PS DESIGN FLOW 240 L.T.A.R. EXISTING

Septic Tank: 1000 Gallons; STB Date

Pump Tank: Gallons; PT Date

Pump Make: Model Serial No.

Nitrification Field: No Fields Square Feet Linear Feet ~300

No Lines THREE Trench Width Max Trench Bottom Depth Gravel Depth

☐ New System ☐ Repair System Type: I II III IV V VI

System Description: CONVENTIONAL GRAVITY

Repair System Description:

Maintenance Agreement Required: ☐ Yes ☑ No

☐ House/Mod. Home ☑ Mobile Home ☐ Business ☐ Other

No. Bedrooms 2 No. Bathrooms 1 No. Employees

☐ Slab ☑ Crawl Space ☐ Basement w/plumbing ☐ Basement wo/plumbing


Water Supply: ☐ Individual ☑ Public ☐ Community

Comments/Conditions:

Comments/Conditions MH & 1/2 OF PARTS OF SYSTEM MAY BE LOCATED ACROSS PROPERTY LINE (c.1962) ; PROPERTY LINE NOT IDENTIFIED AT TIME OF INSPECTION

INITIAL SITE SKETCH

AS BUILT SKETCH

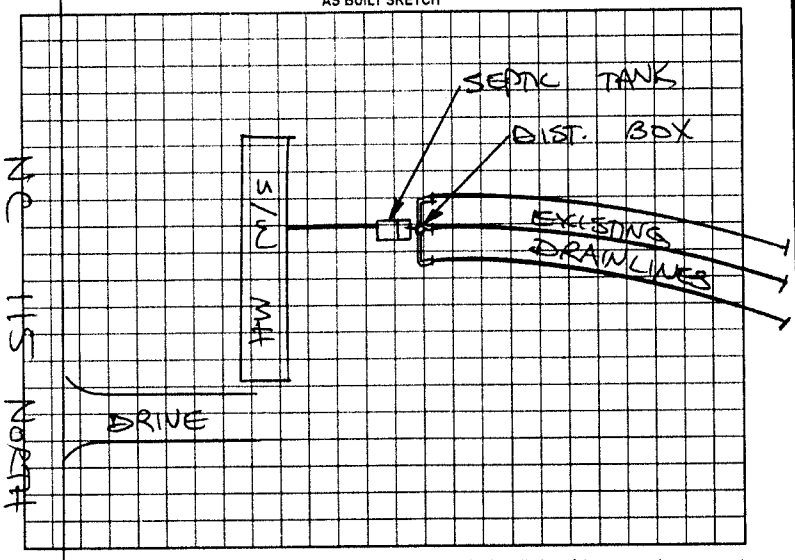

Permit can be suspended or revoked if any false information is supplied toward securing the permit/any unauthorized changes are made to the site/any unauthorized changes are made in the installation of the system. Improvement Permit with plat valid without expiration. Improvement Permit with site plan valid for sixty months. Authorization to Construct is valid for a period equal to that of Improvement Permit - not to exceed sixty months.

Signed: date

Improvement Permit by: date

Authorization to Construct by: date

Installed by:

Operation Permit by: date

Existing System Inspection by: STEVE HEDRICK date 10-25-00

HEALTH DEPT. COPY: WHITE OWNER COPY (FINAL): YELLOW OWNER COPY (INITIAL): PINK