IREDELL COUNTY HEALTH DEPARTMENT

Statesville Office (704) 878-5305 Mooresville Office (704) 660-3625 PERMIT # 219294

IMPROVEMENT PERMIT / AUTHORIZATION TO CONSTRUCT / OPERATION PERMIT / EXISTING SYSTEM

PIN # 4729 112 252

APPLICANT: Nancy Bustle Prevette APPLICANT ADDRESS: 572 Tuckers Grove Rd Statesville NC

SITE ADDRESS: 140 Kingsdale Dr Statesville NC PHONE: 704-876-6912 ALT. PHONE: 704-929-1406

SITE DIRECTIONS: N on Hwy 115 T/L Kingsdale Lot on right

SUBDIVISION: Kingsdale SECTION: N/A LOT # 97/02 LOT AREA: 0.49 ac DESIGN FLOW: 240 L.T.A.R.: Ey

Septic Tank	Ey	(gal)	STB	Date					
Pump Tank		(gal)	PT	Date					
Pump Make		Model		Serial #					
# Nitrification Fields	Ey	# Lines	Ey	Linear Ft:	Ey				
Trench Width	Ey	Max. Trench Bottom Depth	Ey	Gravel Depth					

☐ New System ☐ Repair ☐ Expansion System Type: I II III IV V VI

System Description: Existing

Repair System Description:

Maintenance Agreement Required: ☐ YES ☒ NO

☑ GRAVITY ☐ PRESSURE

☒ Residence No. Bedrooms 2 — Water Supply

☐ Business No. Persons 4 — ☐ Private

☐ Other No. Employees — ☐ Public


☐ Slab ☒ Crawl Space — ☒ Community

☐ Basement w/plumbing ☐ Basement w/o plumbing

Comments / Conditions: All building foundations must be 55' from any part of STS.

INITIAL SITE SKETCH

AS BUILT SKETCH

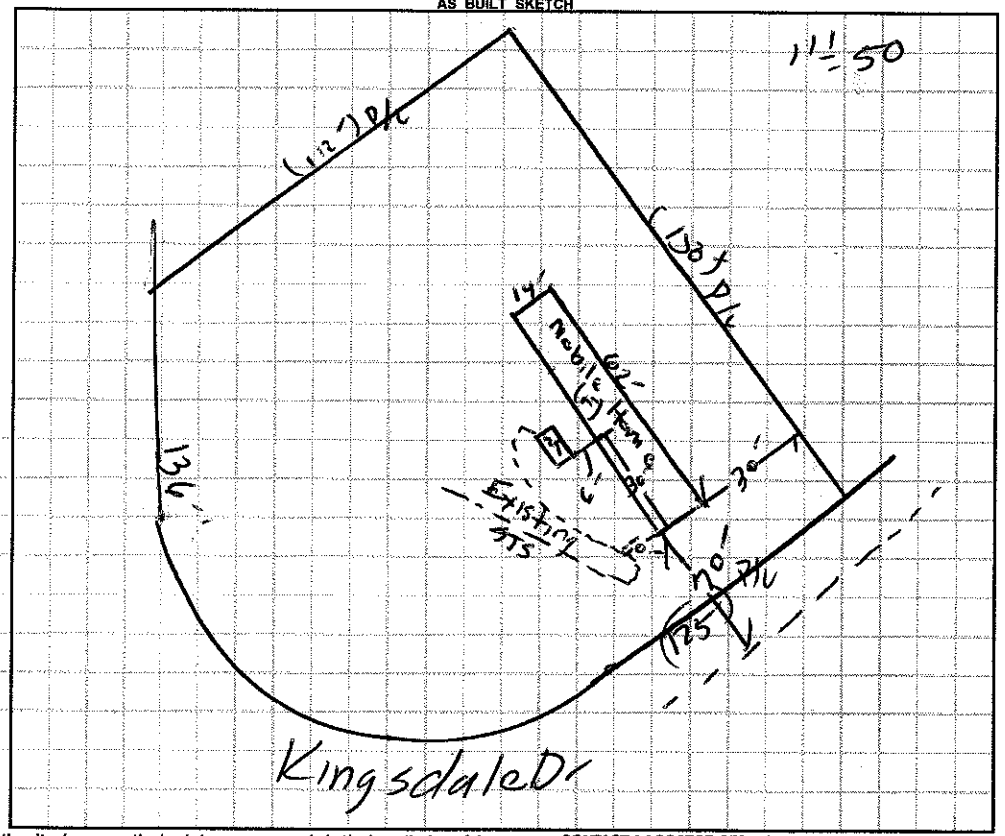

Permit can be suspended or revoked if any false information is supplied toward securing the permit / any unauthorized changes are made to the site / any unauthorized changes are made in the installation of the system. **CONTACT A LOCATOR SERVICE PRIOR TO ANY EXCAVATION**

☐ **IMPROVEMENT PERMIT** *with plat valid without expiration.* ☐ **IMPROVEMENT PERMIT** *with site plan valid for 60 mos.* ☐ **AUTHORIZATION TO CONSTRUCT** *valid for period equal to IMPROVEMENT PERMIT--not to exceed 60 mo.*

Owner / Applicant Signature: Nancy Bustle Prevette Date: 8-01-16 Installed by:

IMPROVEMENT PERMIT by: Date: OPERATION PERMIT by: Date:

AUTHORIZATION TO CONSTRUCT by: Date: Existing System Inspected by: Date: 07/27/16

Health Dept. Copy - WHITE Applicant (Final Approval) - YELLOW Applicant (Conditional Approval) - PINK