IREDELL COUNTY HEALTH DEPARTMENT

STATESVILLE 704-878-5305 MOORESVILLE 704-664-5281

IMPROVEMENT PERMIT / AUTHORIZATION TO CONSTRUCT / OPERATION PERMIT / EXISTING SYSTEM INSPECTION

PERMIT # 15888 PIN # 4729-11-4473 DATE 11-20-09

OWNER or APPLICANT Jesse Shumaker PHONE: Business Home: 704-295-4479

OWNER or APPLICANT ADDRESS 3931 Old Salisbury Rd Wilkesboro NC 28659

LOCATION / DIRECTIONS 115 to Kingsdale Drive to fork 1st on right

SUBDIVISION BLOCK / SECTION LOT # 109 LOT AREA .56 DESIGN FLOW 240 L.T.A.R. 600

Septic Tank Exist Gallons: STB Date

Pump Tank Gallons: P T Date

Pump Make Model Serial #

Nitrification Field No Fields No Lines 2 Linear Feet Exist

Trench Width Exist Max. Trench Bottom Depth Exist Gravel Depth Exist

☑ New System ☐ Repair ☐ Expansion System Type I II IV V VI

System Description: Conventional Trench

Repair System Description:

Maintenance Agreement Required ☐ YES ☑ NO

☐ GRAVITY ☐ PRESSURE

☑ Residence No. Bedrooms 2

☐ Business No. Persons

☐ Other No. Employees

☐ Slab ☑ Crawl Space

☐ Basement w/plumbing ☐ Basement w/o plumbing


Water Supply: ☐ Private ☑ Public ☐ Community

Comments / Conditions

Comments / Conditions

INITIAL SITE SKETCH

AS BUILT SKETCH

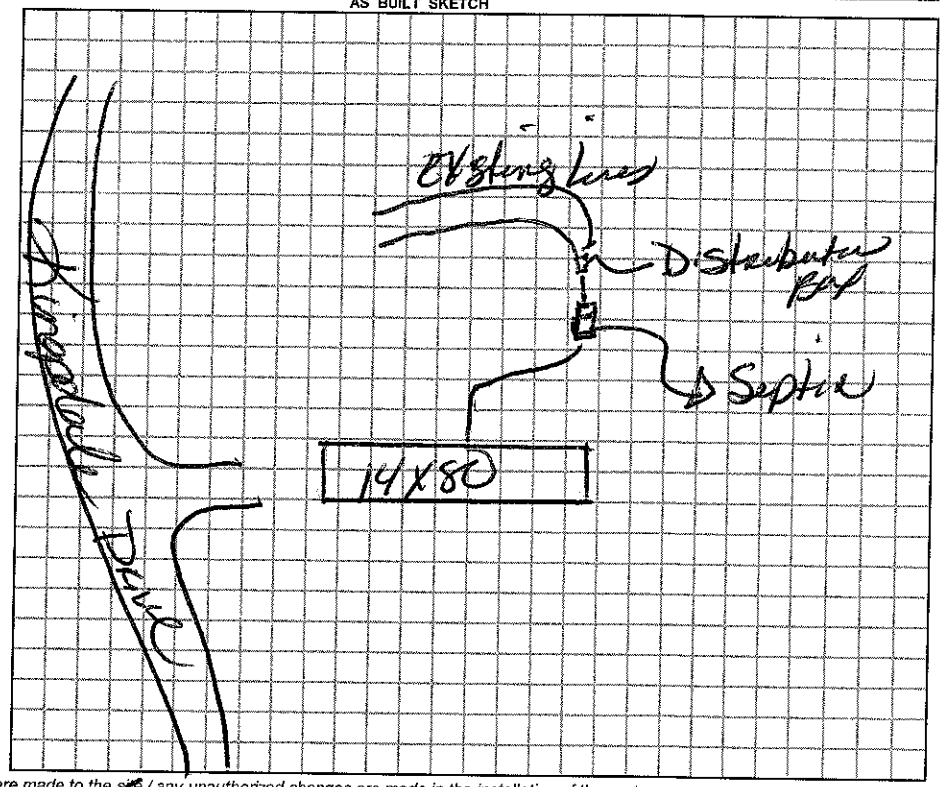

Permit can be suspended or revoked if any false information is supplied toward securing the permit / any unauthorized changes are made to the site / any unauthorized changes are made in the installation of the system.

☐ *IMPROVEMENT PERMIT w / plat valid without expiration.* ☑ *IMPROVEMENT PERMIT w / site plan valid for 60 mos.* ☑ *AUTHORIZATION TO CONSTRUCT valid for period equal to IMPROVEMENT PERMIT-not to exceed 60 mo.*

Owner / Applicant Signature: Jesse Shumaker Date 11/20 09

Improvement Permit by: Date

Authorzation to Construct by: Date

YOU SHOULD CONTACT A LOCATOR SERVICE PRIOR TO ANY EXCAVATION.

Installed by:

Operation Permit by: Date:

Existing System Inspected by: Date: 11-20-09

WHITE COPY Environmental Health YELLOW COPY (Final) Owner / Applicant PINK COPY (Initial) Owner / Applicant