IREDELL COUNTY HEALTH DEPARTMENT

STATESVILLE 704-878-5305 MOORESVILLE 704-664-5281

IMPROVEMENT PERMIT / AUTHORIZATION TO CONSTRUCT / OPERATION PERMIT / EXISTING SYSTEM INSPECTION

PERMIT# 111213 PIN# 4729-11-4473 DATE 2/12/03

OWNER OR CONTRACTOR Jack Holbrook PHONE: Business (704) 902-5500 Home —

ADDRESS 124 King Home Lane, Statesville N.C. 28625

LOCATION Hwy 18 North, TL Knoxdale Rd, Bear Left 2nd mH on Right

SUBDIVISION Kings Gate I BLOCK / SECTION — LOT — LOT AREA .56 Ac SITE CLASS. I DESIGN FLOW — L.T.A.R. Existing

Septic Tank: 1000 Gallons; STB — Date —

Pump Tank: — Gallons; PT — Date —

Pump Make: — Model — Serial No. —

Nitrification Field: No Fields 1 Square Feet — Linear Feet Existing

No Lines Two Trench Width — Max Trench Bottom Depth — Gravel Depth —

☐ New System ☐ Repair System Type: I, II, III, IV, V, VI

System Description: Conv. Gravity

Repair System Description: —

Maintenance Agreement Required: ☐ Yes ☐ No

☐ House/Mod. Home No. Bedrooms —

☒ Mobile Home No. Bathrooms —

☐ Business No. Employees —

☐ Other —

☐ Slab ☒ Crawl Space ☐ Basement w/plumbing ☐ Basement wo/plumbing


Water Supply: ☐ Individual ☒ Public ☐ Community

Comments:/Conditions:


Comments:/Conditions:

House Not Installed at time of Inspection.
Keep House min. 5ft from Septic Tank

INITIAL SITE SKETCH

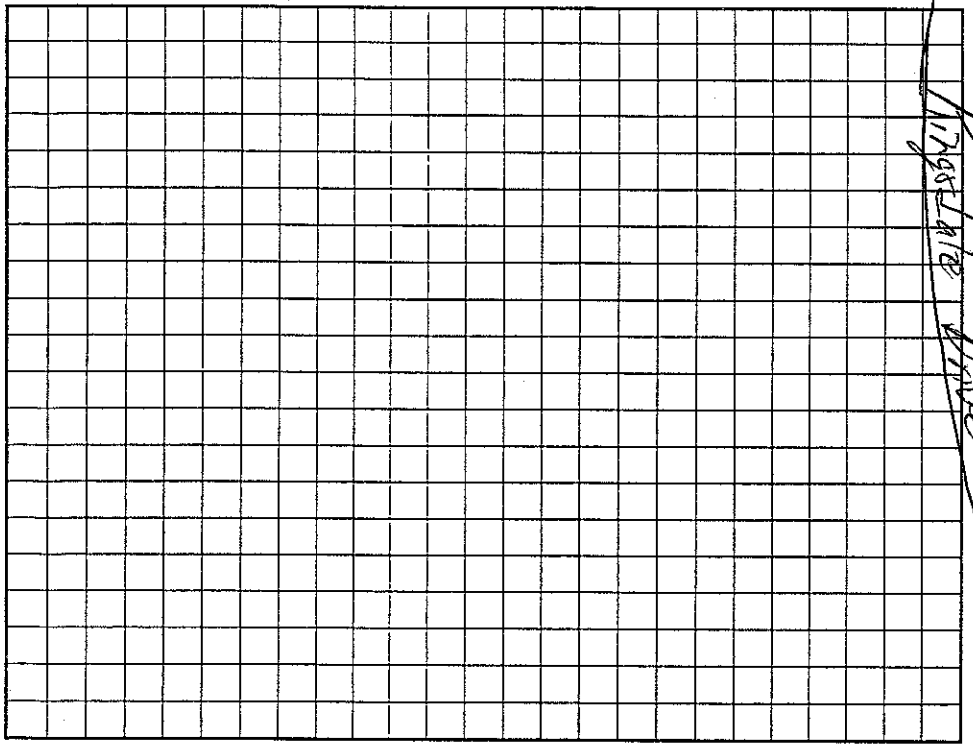

AS BUILT SKETCH

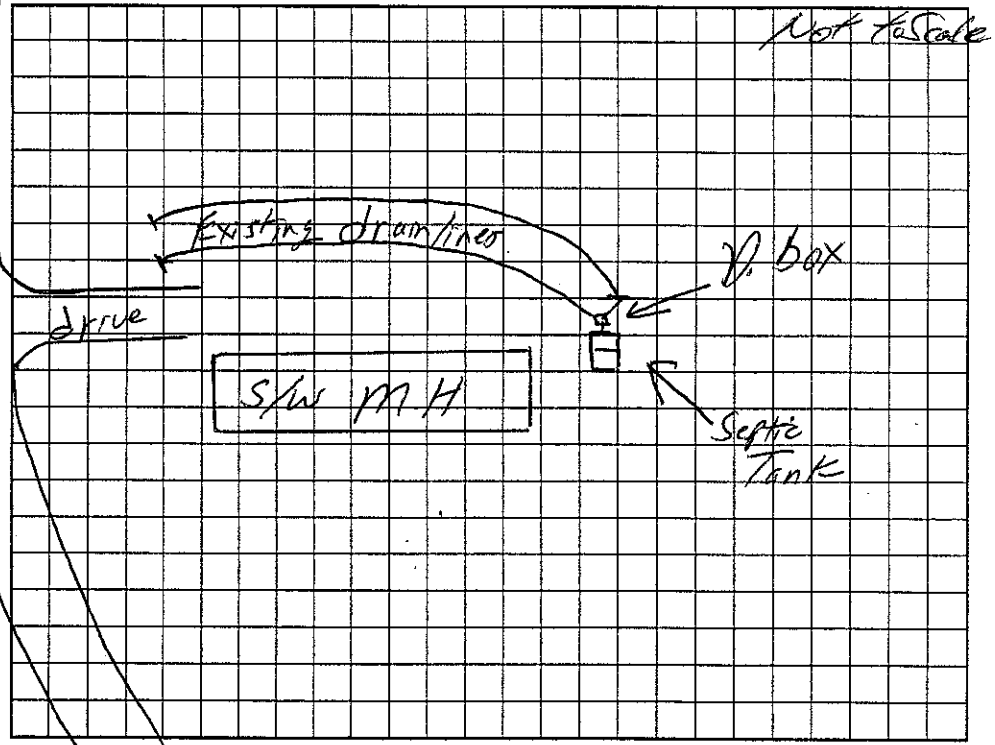

Permit can be suspended or revoked if any false information is supplied toward securing the permit/any unauthorized changes are made to the site/any unauthorized changes are made in the installation of the system. Improvement Permit with plat valid without expiration. Improvement Permit with site plan valid for sixty months. Authorization to Construct is valid for a period equal to that of Improvement Permit – not to exceed sixty months.

Signed: Jack B Holbrook date —

Improvement Permit by: — date —

Authorization to Construct by: — date —

Installed by: —

Operation Permit by: — date —

Existing System Inspection by: William G Johnson date 2/12/03

HEALTH DEPT. COPY: WHITE OWNER COPY (FINAL): YELLOW OWNER COPY (INITIAL): PINK